

Marion
J80
11/74

MISSISSIPPI
BOARD OF WATER COMMISSIONERS
416 North State Street
Jackson, Mississippi 39201

CODED

WATER WELL DRILLERS LOG

Nov. 24 1974 E.B. Sheppard Marion
date well completed firm name county well located

LANDOWNER: Sylvester Craft
Kokomo, Ms.
(mailing address)

description of formations encountered
BED CLAY 0 45
LOOSE BED SANDY CLAY WITH STREAKS 45 90
PEA GR. & SAND 90 146

WELL LOCATION:
sec 18 T 30 N R 12 E
S W
9 miles W of Fowmouth
(distance) (direction) (nearest town)

WELL PURPOSE:
(home) irrigation, municipal, industrial

WELL COMPLETION DATA:

(1) diameter (inches) 2"
(2) total depth (feet) 146'
(3) static water level (feet) 60' below top of ground.
(4) casing pl, 141' (material) (depth)
2" If telescope see back. (size)
(5) screen 5' (length) (depth to top)
2" pl (size) (material)
(6) pump 1 (HP) 7 (yield gpm)
E (type power)
(7) electric log (yes or no)

(organization running log)


(8) how well bottom plugged BWW

DRILLERS REMARKS:

RECEIVED
MAY - 8 1975

If well telescopes please sketch and show depths.

GROUND LEVEL

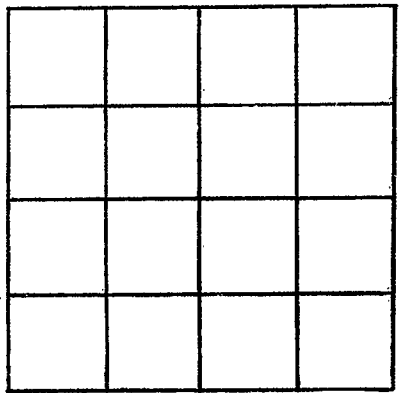

SECTION _____

Please indicate well location X.

ADDITIONAL INFORMATION

A series of horizontal lines for recording additional information, starting below the 'ADDITIONAL INFORMATION' header and extending to the bottom of the page.

If more than one screen, show locations of each on sketch.