

Marion
J 82
12/74

MISSISSIPPI
BOARD OF WATER COMMISSIONERS
416 North State Street
Jackson, Mississippi 39201

CODED

WATER WELL DRILLERS LOG

Dec 1974 E.B. SHERRARD Marion
date well completed firm name county well located

LANDOWNER: NATH McCain
description of formations encountered: LOOSE RED SAND & GR.
from to: 0 170'
Rt. 1 - Kokomo, Ms. (mailing address) MIXED DE-A GR. & SAND 170' 300'

WELL LOCATION:
sec 26 T 3 S R 12 E W
5 miles SW Foxworth
(distance) (direction) (nearest town)

WELL PURPOSE:
(home, irrigation, municipal, industrial)

WELL COMPLETION DATA:
(1) diameter (inches) 2"
(2) total depth (feet) 200'
(3) static water level (feet) 132' below top of ground.
(4) casing (material) pl. (depth) 195'
2" (size) If telescope see back.
(5) screen (length) 5' (depth to top)
2" (size) pl. (material)
(6) pump (HP) 2 (yield gpm) 6
(type power) e
(7) electric log (yes or no) (no)

(organization running log)

(8) how well bottom plugged BWV


DRILLERS REMARKS:

RECEIVED

NOV 28 1974

If well telescopes please sketch and show depths.

GROUND LEVEL

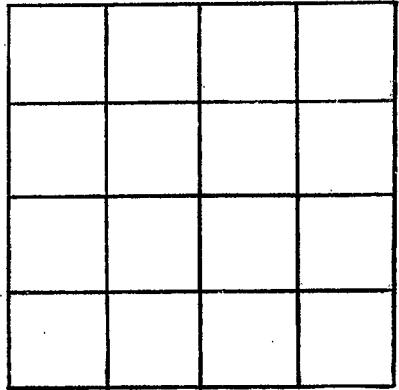

SECTION _____

Please indicate well location X.

ADDITIONAL INFORMATION

If more than one screen, show locations of each on sketch.