

Marion
 583
 275

MISSISSIPPI
 BOARD OF WATER COMMISSIONERS
 416 North State Street
 Jackson, Mississippi 39201

CODED

WATER WELL DRILLERS LOG

Feb. 25 1975 E. B. Sheppard & Marion
 date well completed firm name county well located

LANDOWNER:

Sheppard Taylor
 Foxworth, MS.
 (mailing address)

description of formations encountered

from to

description of formations encountered	from	to
SANDY RED CLAY	0	60
GRAY STRK CLAY		
CLAY SOFT	60	110
SANDY STRKS	110	140
DEA BK. SAND	140	159

WELL LOCATION:

sec. 13 T. 3 N. R. 12 E.
 S W
 5 miles W Foxworth
 (distance) (direction) (nearest town)

WELL PURPOSE:

(home) Irrigation, municipal, industrial

WELL COMPLETION DATA:

- (1) diameter (inches) 2"
- (2) total depth (feet) 159'
- (3) static water level (feet) 111' ^{below} above top of ground.
- (4) casing pl. 154' (material) (depth)
 2" (size) if telescope see back.
- (5) screen 5' (length) (depth to top)
 2" (size) pl. (material)
- (6) pump 1/2 (HP) 6 (yield gpm)
 e (type power)
- (7) electric log (yes or no) (no)

(organization running log)


(8) how well bottom plugged Blk

DRILLERS REMARKS:

RECEIVED
 MAY 8 1975

If well telescopes please sketch and show depths.

GROUND LEVEL

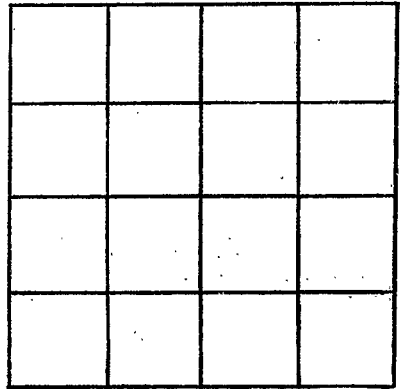

SECTION _____

Please indicate well location X.

ADDITIONAL INFORMATION

If more than one screen, show locations of each on sketch.