

MISSISSIPPI
BOARD OF WATER COMMISSIONERS
416 North State Street
Jackson, Mississippi 39201

CODED

WATER WELL DRILLERS LOG

4-2 1975 Griner-Ginn Marion
date well completed firm name county well located

LANDOWNER: Fonie Earls
Re 1
Joyworth
(mailing address)

WELL LOCATION:
sec. 33 T. 3 N. R. 14 E
10 miles SW of Joyworth
(distance) (direction) (nearest town)

WELL PURPOSE: home
(home, irrigation, municipal, industrial)

- WELL COMPLETION DATA:
- (1) diameter (inches) 4"
 - (2) total depth (feet) 195'
 - (3) static water level (feet) 160' below above top of ground.
 - (4) casing Plastic 185'
(material) (depth)
2" if telescope see back.
(size)
 - (5) screen 10" 185'
(length) (depth to top)
4" Plastic
(size) (material)
 - (6) pump 3/4
(HP) (yield gpm)
Electric
(type power)
 - (7) electric log _____
(yes or no)

(organization running log)
 - (8) how well bottom plugged BW Valve


description of formations encountered	from	to
<u>Top Soil</u>	<u>0</u>	<u>1</u>
<u>Clay</u>	<u>1</u>	<u>46</u>
<u>clay & gravel</u>	<u>46</u>	<u>140</u>
<u>Shale</u>	<u>140</u>	<u>160</u>
<u>Sand</u>	<u>160</u>	<u>195</u>

DRILLERS REMARKS:

RECEIVED
JUN 6 1975

If well telescopes please sketch and show depths.

GROUND LEVEL

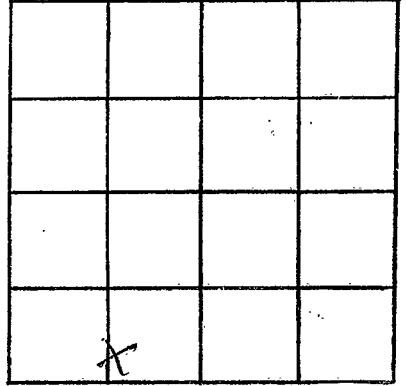

SECTION 83

Please indicate well location X:

ADDITIONAL INFORMATION

If more than one screen, show locations of each on sketch.