

J 85  
 Marion  
 2/5/75

MISSISSIPPI  
 BOARD OF WATER COMMISSIONERS  
 416 North State Street  
 Jackson, Mississippi 39201

CODED

WATER WELL DRILLERS LOG

2-5 1975 Criver - Ginn Marion  
 date well completed firm name county well located

LANDOWNER:

Eugene Watson  
 Rt. 2, Box 266 Foxworth  
 (mailing address)

description of formations encountered

from to

top soil	0	1
clay	1	65
clay + gravel	65	120
chert	120	130
sand	130	170

WELL LOCATION:

sec. 35 T 3 N R 12 E  
 10 miles SW of Foxworth  
 (distance) (direction) (nearest town)

WELL PURPOSE:

Home (home, irrigation, municipal, industrial)

WELL COMPLETION DATA:


- (1) diameter (inches) 4"
- (2) total depth (feet) 170
- (3) static water level (feet) 130 below top of ground.
- (4) casing PVC, 160 (material), (depth)  
 4" (size) if telescope see back.
- (5) screen 10' 160 (length), (depth to top)  
 4" (size), PVC (material)
- (6) pump 3/4 (HP), (yield gpm)  
 elec (type power)
- (7) electric log 170 (yes or no)

(organization running log)

(8) how well bottom plugged

B.W. Valve


DRILLERS REMARKS:

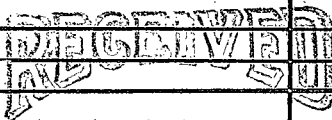

JUN 6 1975

If well telescopes please sketch and show depths.

GROUND LEVEL

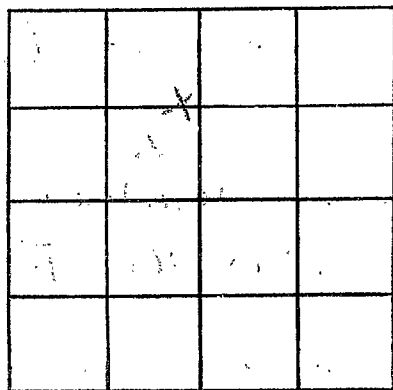

SECTION 35

Please indicate well location X.

ADDITIONAL INFORMATION

If more than one screen, show locations of each on sketch.