

J 87
 Marion
 3/10/75

MISSISSIPPI
 BOARD OF WATER COMMISSIONERS
 416 North State Street
 Jackson, Mississippi 39201

CODED

WATER WELL DRILLERS LOG

3-10 1975 Criner-Coinu MARION
 date well completed firm name county well located

LANDOWNER:
 Reggie BARBER
 Rt. 1 Foxworth, Miss
 (mailing address)

| description of formations encountered | from | to |
|---------------------------------------|------|-----|
| Top Soil | 0 | 1 |
| Clay | 1 | 28 |
| Clay + gravel | 28 | 90 |
| Sand + gravel | 90 | 160 |
| Clay | 160 | 180 |
| Sand | 180 | 210 |

WELL LOCATION:
 sec. 28 T. 3 N. R. 4 E.
 8 miles SW of Foxworth
 (distance) (direction) (nearest town)

WELL PURPOSE: Home
 (home, irrigation, municipal, industrial)

WELL COMPLETION DATA:

(1) diameter (inches) 4"

(2) total depth (feet) 220

(3) static water level (feet) 150' below top of ground.

(4) casing PVC, 210' (material) (depth)
 4" (size) if telescope see back.

(5) screen 10' (length), 210' (depth to top)
 4" (size) PVC (material)

(6) pump 3/4 (HP), (yield gpm)
 elec (type power)

(7) electric log No (yes or no)
 (organization running log)


(8) how well bottom plugged B.W. valve

RECEIVED
 JUN - 8 1975

DRILLERS REMARKS:

If well telescopes please sketch and show depths.

GROUND LEVEL

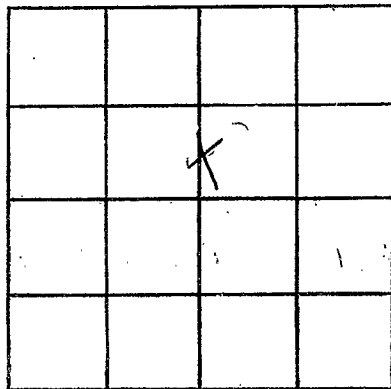

SECTION 28

Please indicate well location X.

ADDITIONAL INFORMATION

If more than one screen,
show locations of each on sketch.