

County: Madison  
 Permit #: 0-586  
 Driller: JAMES WELLS  
 Date drilling completed: 3-27-12

**State Well Report**  
 Part 1 - Driller's Log  
 Mississippi Department of Environmental Quality  
 Office of Land and Water Resources  
 P.O. Box 2309  
 Jackson, MS 39225  
 (601)961- 5210  
 (601)961- 5228 (fax)

For Office Use Only:  
 Aquifer: \_\_\_\_\_  
 Well #: J112  
 L. S. Elevation: \_\_\_\_\_  
 E-log #: \_\_\_\_\_

*State Law requires that this report be prepared by the license holder responsible for the work and filed with the Department at the above address within 30 days of completion of drilling of the well or borehole.*

<p><b>Information on Well Owner</b>          (Landowner if borehole is not for a water well)</p> <p>Owner Name: <u>Mike Anthony</u>          Mailing Address: <u>225 Stovall Rd.</u>  <u>Foxworth MS 39483</u>          City State Zip Code          Telephone No. <u>(601) 441-4116</u></p>	<p><b>Well or Borehole Location</b></p> <p>Latitude: <u>31°15.199</u> Longitude: <u>090°00.352</u>          Method of Lat/Long (circle one): <u>12</u> Conventional Survey, <u>21</u>          USGS quad, Hand-held GPS, Survey-grade GPS <input checked="" type="checkbox"/>          NW ¼ SW ¼ Sec <u>A</u> Twn <u>34</u> Rng <u>12 E</u>          Distance Direction Nearest Town  <u>7</u> Miles <u>West</u> of <u>Foxworth</u></p>
--	---

**Well / Borehole Data**

Date drilling started: 3-27-12 Date drilling completed: 3-27-12 Hole depth: 260 Hole diameter: 7

Location of the source of any surface water used for drilling: Creek  
 Method of dosing and volume of Chlorine used in drilling and development: 300 Shock

Logs run (circle all applicable): No log run  EL  Gamma Ray Density Sonic Neutron Other: \_\_\_\_\_  
 Name of organization running log(s): \_\_\_\_\_

Purpose of borehole (check one): Water Well  Geotechnical/Geological Investigation \_\_\_\_\_ Ground Source Heat Pump \_\_\_\_\_  
 Seismic Survey \_\_\_\_\_ Other (describe) \_\_\_\_\_

*If drilling is not related to water well construction, skip the remainder of this block*

Purpose of Well (check one): Home \_\_\_\_\_ Industrial  Public Supply \_\_\_\_\_ Irrigation \_\_\_\_\_ Fish Culture \_\_\_\_\_ Other: \_\_\_\_\_

If a flowing well, method of flow regulation: Valve \_\_\_\_\_ Other (describe) \_\_\_\_\_

Static Water Level: 95 feet above or below (circle one) land surface Date measured: 3-27-12

Method of Measurement (circle one) steel tape electric tape air line other: \_\_\_\_\_

Well depth: 260 Well grouted to a depth of 10 feet Type of grout (circle one): Neat Cement Bentonite Mix

Casing length: 220 feet Casing diameter: 4 inches Type of casing: PVC

Screen length: 40 feet Screen diameter: 4 inches Type of screen: PVC

Screen slot size: .008 inches Setting depth: From 220 feet to 260 feet

Type of completion (circle all applicable): Gravel packed Underreamed Telescoped Open hole Natural Development  
 Other (describe): \_\_\_\_\_

Top of lap pipe or reduction in casing: \_\_\_\_\_ feet. *If telescoped or more than one screen, describe on next page*


Form: OLWR-SWR-1A (04/08)

RECEIVED  
 MAY 01 2012  
 BY: OLWR

5712

If well telescopes please sketch below and show depths.

Ground Level

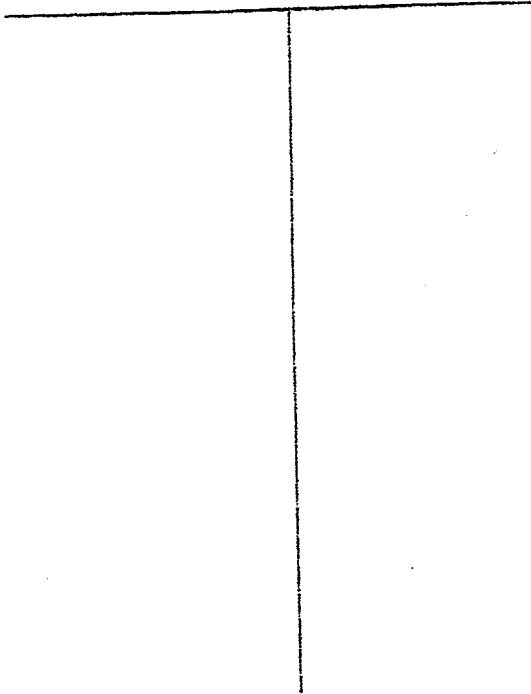

Description of Formations Encountered	From	To
Clay	0	10
Sand	10	80
Clay	80	150
Sand	150	200
fine sand	200	260

If more than one screen, show location of each on sketch

Sketch the property layout and include the following: 1) the well location; 2) any permanent structures on the property that may aid in locating the well; 3) any roads, power lines, or other items that may aid in locating the property and the well; 4) indicate direction.

Landowner Name: Mike Anthony

James Wells  
Signature of Water Well Contractor

RECEIVED  
MAY 01 2012  
BY: OLWR

# STATE WELL REPORT

## Part 2

Pump Installer's Completion Report  
 Mississippi Department of Environmental Quality  
 Office of Land and Water Resources  
 P.O. Box 10631  
 Jackson, MS 39289-0631  
 (601)961-5210  
 (601)354-6938 (fax)

For Office Use Only:

Aquifer: \_\_\_\_\_

Well #: J112

Elevation: \_\_\_\_\_

County: Meridian  
 Permit #: \_\_\_\_\_  
 Driller: JAMES WELLS  
 Date completed: 3-27-12

This report should be prepared by the pump installer in detail and filed with the Department within 30 days of the installation of pump.

Well Owner Information	Well Location
Owner Name: <u>Mike Anthony</u>	Latitude: <u>31°15'199</u> Longitude: <u>090°00'352</u>
Mailing Address: <u>225 Stovall Rd.</u>	Method of Lat/Long (circle one): <u>Conventional Survey</u>
<u>Foxworth MS 39483</u>	USGS quad, Hand-held GPS, Survey-grade GPS
City State Zip Code	<u>1/4</u> <u>1/4</u> Sec <u>S</u> Twp <u>3n</u> Rng <u>12E</u>
Telephone No. <u>(601) 441-4116</u>	Distance Direction Nearest Town
	<u>7</u> Miles <u>West</u> of <u>Foxworth MS</u>

Pump Type Circle one	Power Type Circle one
Air Lift Jet <u>Submersible</u>	Diesel Engine Gasoline Engine Natural Gas
Bucket Piston Turbine	<u>Electric Motor</u> Hand Tractor PTO
Centrifugal Rotary Flowing Well	Windmill Other (specify): _____
Other (specify): _____	Horse Power Rating of Motor: <u>5 H.P.</u>
Date Pump Installed: _____	Setting Depth: <u>150</u> feet
Rated Pump Capacity: <u>50</u> Gallons Per Minute	Number of Stages: <u>11</u>

Pump Test Data	Method of Measuring Water Level Circle one
Date Well Tested: <u>3-27-12</u>	Air Line Electric Measuring Line Steel Tape
Static Water Level (A): <u>95'</u> Feet Below Land Surface	Other (specify): _____
Pumping Water Level (B): <u>150'</u> Feet Below Land Surface	For flowing well, measured shut in head: _____ feet
Drawdown [(B) - (A)]: <u>120</u> Feet Below Land Surface	Well yielded <u>50</u> GPM with a drawdown of
Test Pumping Rate: <u>50</u> Gallons Per Minute	<u>95'</u> feet after <u>4</u> hours of pumping
Duration of Pump Test (minimum 4 hours): <u>4</u> hours	

I HEREBY CERTIFY that the above statements are true to the best of my knowledge.

JAMES WELLS 0-586  
 Print Name of Pump Installer and License No. (if applicable)

James Wells  
 Signature of Pump Installer

RECEIVED

MAY 01 2012

BY: OLWR