

Marion
 J 2001
 9/75

MISSISSIPPI
 BOARD OF WATER COMMISSIONERS
 416 North State Street
 Jackson, Mississippi 39201

WATER WELL DRILLERS LOG

Sept. 25 E. B. Sheppard Marion
 date well completed firm name county well located

LANDOWNER:
 C. W. McHowan
 Forworthy Ms.
 (mailing address)

description of formations encountered	from	to
GRAYISH SANDY CLAY	0	60'
BLUE CLAY	60'	140'
FINE SAND	140'	160'
COARSE SAND & GRAVEL	160'	178'

WELL LOCATION:
 sec 10 T 3 N R 12 E 13V
 6 miles W Forworthy
 (distance) (direction) (nearest town)

WELL PURPOSE:
 (home) irrigation, municipal, industrial

WELL COMPLETION DATA:


(1) diameter (inches) 2"
 (2) total depth (feet) 178'
 (3) static water level (feet) 110' ^{below} above top of ground.
 (4) casing pl. 173' (material) (depth)
 2" (size) if telescope see back.
 (5) screen 5' (length) (depth to top)
 2" (size) pl. (material)
 (6) pump 1 1/2 (HP) 7 (yield gpm)
 E (type power)
 (7) electric log (yes or no) no
 (organization running log)
 (8) how well bottom plugged BWV

DRILLERS REMARKS:

REGISTERED
 DEC 5 1975
 MISS. BD. OF WATER COMMISSIONERS

If well telescopes please sketch and show depths.

GROUND LEVEL

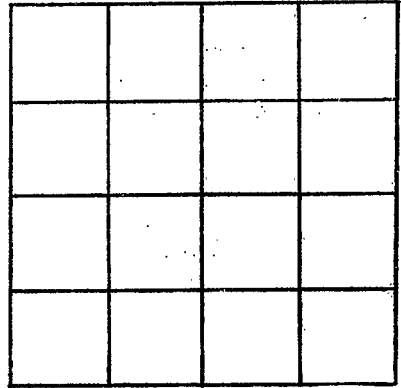

SECTION _____

Please indicate well location X.

ADDITIONAL INFORMATION

If more than one screen, show locations of each on sketch.