

Marion
 J 2002
 9/75

MISSISSIPPI
 BOARD OF WATER COMMISSIONERS
 416 North State Street
 Jackson, Mississippi 39201

WATER WELL DRILLERS LOG

Sept. 75 date well completed
 E.B. Sherard firm name
 Marion county well located


LANDOWNER:	description of formations encountered	from	to
Ray Lee Coleman Foxworth Ms. (mailing address)			
WELL LOCATION:			
sec. 10 T. 3 N. R. 12 E. 13V			
6 miles W Foxworth (distance) (direction) (nearest town)			
WELL PURPOSE:			
(home, irrigation, municipal, industrial)			
WELL COMPLETION DATA:			
(1) diameter (inches) 2"			
(2) total depth (feet) 64'			
(3) static water level (feet) 40' below top of ground.			
(4) casing (material) pl. (depth) 59'			
2" (size) if telescope see back.			
(5) screen (length) 5' (depth to top)			
2" (size) pl. (material)			
(6) pump (HP) 1 (yield gpm) 7			
E (type power)			
(7) electric log (yes or no) <input checked="" type="checkbox"/>			
(organization running log)			
(8) how well bottom plugged BWV			
DRILLERS REMARKS:			

RECEIVED
 DEC - 5 1975

MISS. BD. OF WATER COMAR

If well telescopes please sketch and show depths.

GROUND LEVEL

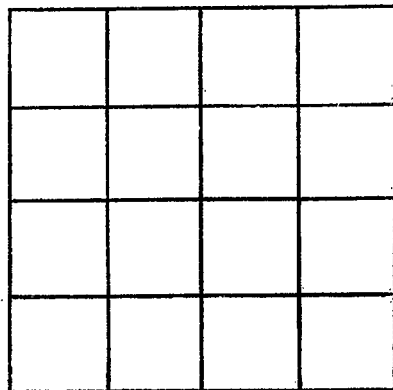

SECTION _____

Please indicate well location X.

ADDITIONAL INFORMATION

If more than one screen, show locations of each on sketch.