

Marion
 J 2003
 9-19-75

MISSISSIPPI
 BOARD OF WATER COMMISSIONERS
 416 North State Street
 Jackson, Mississippi 39201

WATER WELL DRILLERS LOG

9-19 1975 Crocker-Blum Marion
 date well completed firm name county well located

LANDOWNER:
Donnie Williamson
Forkworth Miss
 (mailing address)

description of formations encountered	from	to
Top Soil	0	1
clay	1	14
clay & chalk.	14	54
chalk.	54	91
SAND	91	109

WELL LOCATION:
 sec. 25 T. 3 N R. 12 E
4 miles E of Kokomo
 (distance) (direction) (nearest town)

WELL PURPOSE:
 (home, irrigation, municipal, industrial)

- WELL COMPLETION DATA:
- (1) diameter (inches) 2"
 - (2) total depth (feet) 109
 - (3) static water level (feet) 80 below above top of ground.
 - (4) casing PVC, 99,
 (material) (depth)
2" if telescope see back.
 (size)
 - (5) screen 10', 99
 (length) (depth to top)
2", PVC
 (size) (material)
 - (6) pump 1,
 (HP) (yield gpm)
elec
 (type power)
 - (7) electric log NO
 (yes or no)
 (organization running log)
 - (8) how well bottom plugged B.W. Valve


DRILLERS REMARKS:

DEC 15 1975

MISS. BD. OF WATER COMM.

If well telescopes please sketch and show depths.

GROUND LEVEL

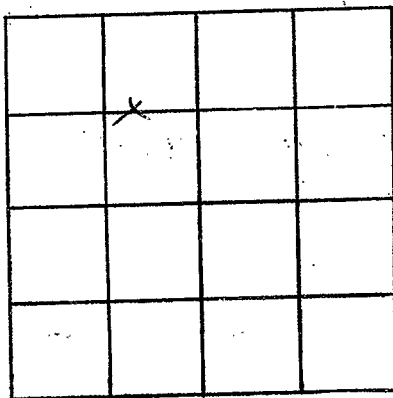

SECTION 25

Please indicate well location X.

ADDITIONAL INFORMATION

If more than one screen,
show locations of each on sketch.