

Marion
 12 2004
 11/75

MISSISSIPPI
 BOARD OF WATER COMMISSIONERS
 416 North State Street
 Jackson, Mississippi 39201

WATER WELL DRILLERS LOG

Nov 1975 E.B. Sheppard Marion
 date/well completed firm name county well located

LANDOWNER:

Clifford R. Ward
 Rt. 3 - Foxworth, Ms
 (mailing address)

description of formations encountered

from to

BED SANDY CLAY	0	80'
SAND + GR.		
DRY 2" WATER	80	95'
BLUE CLAY	95	160'
COARSE SAND	160	180'

WELL LOCATION:

sec 36 T 30 N R 12 E 130
 S W
 4 miles SW Foxworth
 (distance) (direction) (nearest town)

WELL PURPOSE:

(home) irrigation, municipal, industrial

WELL COMPLETION DATA:

- (1) diameter (inches) 2"
- (2) total depth (feet) 180'
- (3) static water level (feet) 112' ^{below} top of ground
- (4) casing pl 175' (material) (depth)
 2" (size) if telescope see back.
- (5) screen 5' (length) (depth to top)
 2" (size) pl (material)
- (6) pump 1 1/2 (HP) 6 (yield gpm)
 e (type power)
- (7) electric log (yes or no)

(organization running log)

(8) how well bottom plugged BNV


DRILLERS REMARKS:

RECEIVED
 DEC - 5 1975

MISS. RD. OF WATER COMMISSIONERS

If well telescopes please sketch and show depths.

GROUND LEVEL

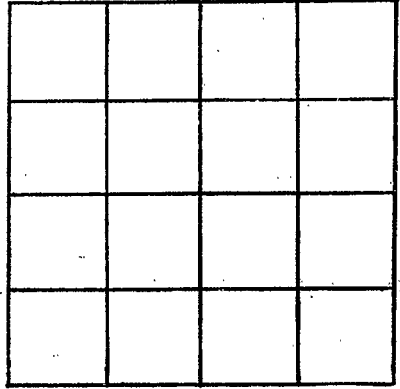

SECTION _____

Please indicate well location X.

ADDITIONAL INFORMATION

If more than one screen, show locations of each on sketch.