

Marion
 T 2006
 2/76

MISSISSIPPI
 BOARD OF WATER COMMISSIONERS
 416 North State Street
 Jackson, Mississippi 39201

WATER WELL DRILLERS LOG

Feb. 19 76 date well completed
 E.B. Sheppard firm name
 Marion county well located

LANDOWNER:
 D.C. Taylor
 Kokemo, Miss.
 (mailing address)

description of formations encountered	from	to
RED SANDY CLAY	0	80'
CLAY GRAY	80'	170'
CLAY	170'	190'
SMALL SAND	170'	190'
COARSE SAND	190'	220'
LITTLE PEA GR.	190'	220'

WELL LOCATION:
 sec 22 T 30 N R 12 E
 S W
 6 miles WSW of Jayworth
 (distance) (direction) (nearest town)

WELL PURPOSE:
 (home) irrigation, municipal, industrial

- WELL COMPLETION DATA:
- (1) diameter (inches) 2"
 - (2) total depth (feet) 220'
 - (3) static water level (feet) 80' below top of ground. above
 - (4) casing pl. 215'
 (material) (depth)
2" if telescope see back.
 (size)
 - (5) screen 5'
 (length) (depth to top)
2" pl.
 (size) (material)
 - (6) pump 1 1/2 7
 (HP) (yield gpm)
elec.
 (type power)
 - (7) electric log (yes or no) no
 - (organization running log)
 - (8) how well bottom plugged BWV


RECEIVED
 OCT 18 1976

MISS. BB. OF WATER COMMISSIONERS

DRILLERS REMARKS:

If well telescopes please sketch and show depths.

GROUND LEVEL

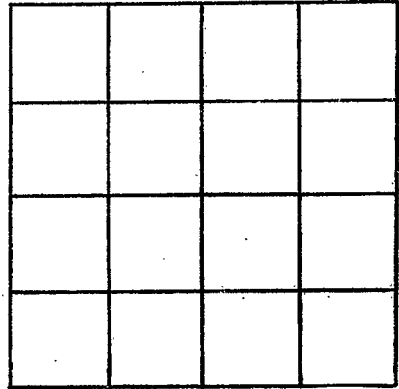

SECTION _____

Please indicate well location X.

ADDITIONAL INFORMATION

If more than one screen, show locations of each on sketch.