

Marion
J 2007
3/76

MISSISSIPPI
 BOARD OF WATER COMMISSIONERS
 416 North State Street
 Jackson, Mississippi 39201

WATER WELL DRILLERS LOG

March 1976 E.B. Sherrard Marion
 date well completed firm name county well located

LANDOWNER:

Earl Ray Price, Jr.
Rt. 3, Foywath, Ms.
 (mailing address)

description of formations encountered

from to

<u>RED SANDY CLAY</u>	<u>0</u>	<u>70'</u>
<u>SANDY & MIXED SHAVEL CLAY</u>	<u>70'</u>	<u>120'</u>
<u>FINE SAND</u>	<u>120'</u>	<u>170'</u>
<u>COARSE SAND & CL.</u>	<u>170'</u>	<u>200'</u>
	<u>200'</u>	<u>246'</u>

WELL LOCATION:

sec 26 T 3 N 12 E
 S W
6 miles SW Foywath
 (distance) (direction) (nearest town)

WELL PURPOSE:

(home) Irrigation, municipal, industrial

WELL COMPLETION DATA:

- (1) diameter (inches) 4"
- (2) total depth (feet) 246'
- (3) static water level (feet) 90' below top of ground.
- (4) casing pl. 236'
 (material) (depth)
4"
 (size) If telescope see back.
- (5) screen 10'
 (length) (depth to top)
4" pl.
 (size) (material)
- (6) pump 3/4 sub. 20
 (HP) (yield gpm)
Elec.
 (type power)
- (7) electric log (yes or no)

(organization running log)

(8) how well bottom plugged B/W


DRILLERS REMARKS:

RECEIVED
 OCT 18 1976

MISS. BD. OF WATER COMMISSIONERS

If well telescopes please sketch and show depths.

GROUND LEVEL

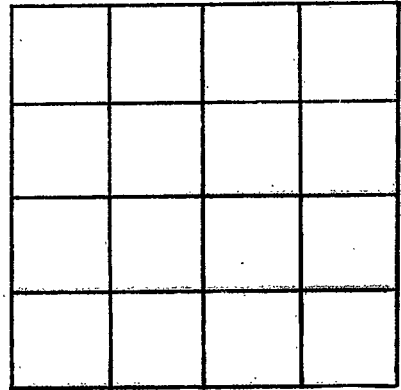

SECTION _____

Please indicate well location X.

ADDITIONAL INFORMATION

If more than one screen, show locations of each on sketch.