

Marion
 J 2008
 7-8-76

MISSISSIPPI
 BOARD OF WATER COMMISSIONERS
 416 North State Street
 Jackson, Mississippi 39201

WATER WELL DRILLERS LOG

7-8 1976 Griner-Ginn Marion
 date well completed firm name county well located

LANDOWNER:

Frank Taylor
 Rt. 1 Kokomo, Miss.
 (mailing address)

description of formations encountered

description of formations encountered	from	to
Top Soil	0	1
a lay gravel	1	45
CHALK	45	81
SAND - FINE	81	95

WELL LOCATION:

sec. 14 T 3 N R 12 E
 6 miles SW of Forwood
 (distance) (direction) (nearest town)

WELL PURPOSE: HOME
 (home, irrigation, municipal, industrial)

WELL COMPLETION DATA:

- diameter (inches) 4"
- total depth (feet) 105'
- static water level (feet) 50 below top of ground.
- casing PVC, 95' (material), (depth)
 4" (size) if telescope see back.
- screen 10' 95' (length), (depth to top)
 4" PVC (size), (material)
- pump 3/4 14 ✓ (HP), (yield gpm)
 elec (type power)
- electric log NO (yes or no)
 (organization running log)

(8) how well bottom plugged
 BW Valve

DRILLERS REMARKS:


RECEIVED

OCT 18 1976

MISS. BD. OF WATER COMM

If well telescopes please sketch and show depths.

GROUND LEVEL

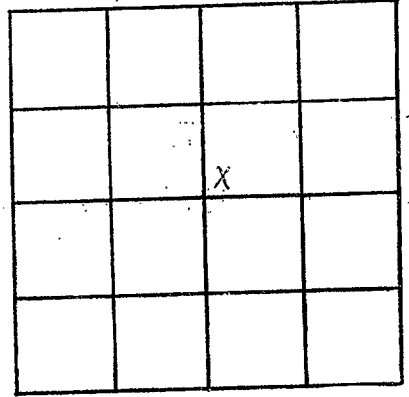

SECTION 14

Please indicate well location X.

ADDITIONAL INFORMATION

If more than one screen,
show locations of each on sketch.