

Marion  
 J 2009  
 10-17-76

MISSISSIPPI  
 BOARD OF WATER COMMISSIONERS  
 416 North State Street  
 Jackson, Mississippi 39201

WATER WELL DRILLERS LOG

10-17 1976 Hollinger Plumb. Marion  
 date well completed firm name county well located


LANDOWNER: Larry Stojan RT1	description of formations encountered	from	to
Kokomo, Miss (mailing address)	Red clay sand & gravel	0	20 136
WELL LOCATION: sec. 10 T-3 N R-12 E S W 5 miles N of Kokomo (distance) (direction) (nearest town)			
WELL PURPOSE: Home (home, irrigation, municipal, industrial)			
WELL COMPLETION DATA:			
(1) diameter (inches) 4"			
(2) total depth (feet) 136			
(3) static water level (feet) 50 below top of ground.			
(4) casing PVC, 136, (material) (depth)			
No (size) if telescope see back.			
(5) screen 5 ft., 131 (length) (depth to top)			
4 PVC (size) (material)			
(6) pump 1/2 HP, 11 (yield gpm)			
elect. (type power)			
(7) electric log No (yes or no)			
(organization running log)			
(8) how well bottom plugged sand shale			
DRILLERS REMARKS: good well			

RECEIVED

NOV 18 1976

If well telescopes please sketch and show depths.

GROUND LEVEL

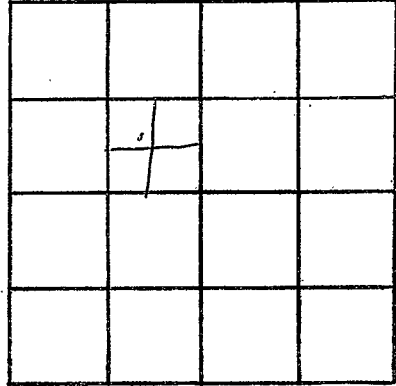

SECTION 10

Please indicate well location X.

ADDITIONAL INFORMATION

If more than one screen, show locations of each on sketch.