

Marion
 J 2010
 11-10-76

MISSISSIPPI
 BOARD OF WATER COMMISSIONERS
 416 North State Street
 132A Jackson, Mississippi 39201

WATER WELL DRILLERS LOG

11-10 1976 Orner-Ginn Marion
 date well completed firm name county well located

LANDOWNER:

Shirley Earl Coverly
 Kokomo,
 (mailing address) Miss.

description of formations encountered

from to

Top Soil	0	1
Clay	1	36
Chalk	36	91
Chalk + gravel	91	131
SAND	131	165

WELL LOCATION:

sec. 17 T. 3 N R. 12 E
~~21~~ miles N of Kokomo
 (distance) (direction) (nearest town)

WELL PURPOSE:

Home
 (home, irrigation, municipal, industrial)

WELL COMPLETION DATA:

- (1) diameter (inches) 2"
 (2) total depth (feet) 165
 (3) static water level (feet) 100 below above top of ground.
 (4) casing PVC, 155,
 (material) (depth)
2"
 (size) if telescope see back.
 (5) screen 10', 155
 (length) (depth to top)
2", PVC
 (size) (material)
 (6) pump 1 1/2 (HP) (yield gpm)
elec
 (type power)
 (7) electric log NO
 (yes or no)

(organization running log)

- (8) how well bottom plugged
B.W. Valve

DRILLERS REMARKS:


RECEIVED

MAR 23 1977

MISS. BD. OF WATER COMMISSIONERS

If well telescopes please sketch and show depths.

GROUND LEVEL

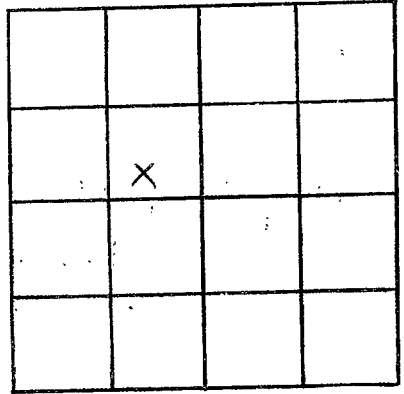

SECTION 17

Please indicate well location X.

ADDITIONAL INFORMATION

If more than one screen, show locations of each on sketch.