

Marion
J 2011
12/10/76

MISSISSIPPI
 BOARD OF WATER COMMISSIONERS
 416 North State Street
 Jackson, Mississippi 39201

13V

WATER WELL DRILLERS LOG

12-10 1976 Hollinger Plumb Marion
 date well completed firm name county well located

LANDOWNER: Fleet Holmes
Rt 2
Kokomo, Miss.
 (mailing address)

description of formations encountered	from	to
<u>Red clay, sand</u>	<u>0</u>	<u>35</u>
<u>sand, gravel</u>	<u>35</u>	<u>156</u>

WELL LOCATION:
 sec. 10 T. 3 (N) S R. 12 (E) W
4 1/2 miles N of KOKOMO
 (distance) (direction) (nearest town)

WELL PURPOSE: Home
 (home, irrigation, municipal, industrial)

WELL COMPLETION DATA:

(1) diameter (inches) 2"

(2) total depth (feet) 156 ft.

(3) static water level (feet) 156 below above top of ground.

(4) casing PVC, 156,
 (material) (depth)
 (size) If telescope see back.

(5) screen 5, 151
 (length) (depth to top)
2", PVC
 (size) (material)

(6) pump 1, 7
 (HP) (yield gpm)
elect.
 (type power)

(7) electric log (yes or no) _____
 (organization running log) _____

(8) how well bottom plugged sand
SHARIC


DRILLERS REMARKS: good well

RECEIVED
 JAN 10 1977

MISS. Bd. OF WATER COMMISSIONERS

If well telescopes please sketch and show depths.

GROUND LEVEL

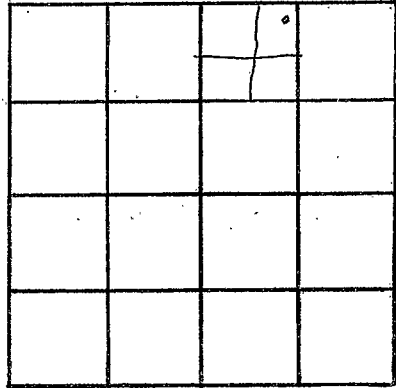

SECTION 10

Please indicate well location X.

ADDITIONAL INFORMATION

If more than one screen,
show locations of each on sketch.