

MARTON
 J 2012
 12/20/76

MISSISSIPPI
 BOARD OF WATER COMMISSIONERS
 416 North State Street
 Jackson, Mississippi 39201

WATER WELL DRILLERS LOG

12-20 1976 Hollinger Plumb MARION
 date well completed firm name county well located

LANDOWNER: D.W. Statum
 RT1
 Kokomo, Miss
 (mailing address)

description of formations encountered	from	to
Red clay, chalk	0	60
sand, gravel	60	160

WELL LOCATION:
 sec 35 T 38 N R 22 E
 5 1/2 miles S E of Kokomo
 (distance) (direction) (nearest town)

WELL PURPOSE: Home
 (home, irrigation, municipal, industrial)

WELL COMPLETION DATA:

(1) diameter (inches) 4

(2) total depth (feet) 160

(3) static water level (feet) 60 below top of ground.

(4) casing PVC, 160, (material) (depth)
 (size) If telescope see back.

(5) screen 10, 150 (length) (depth to top)
 4, PVC (size) (material)

(6) pump 1, 15 (HP) (yield gpm)
 elect (type power)

(7) electric log (yes or no)

(organization running log)

(8) how well bottom plugged sand shale


DRILLERS REMARKS: good well

RECEIVED
 JAN 10 1977

MISS. BD. OF WATER COM.

If well telescopes please sketch and show depths.

GROUND LEVEL

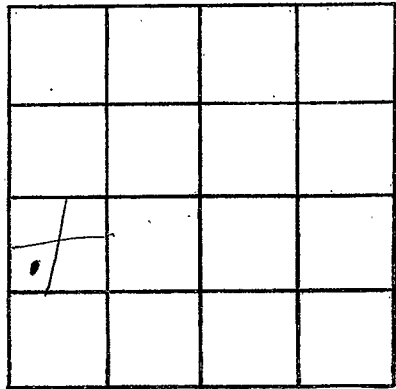

SECTION 35

Please indicate well location X.

ADDITIONAL INFORMATION

If more than one screen,
show locations of each on sketch.