

Marion
 J 2013
 1-3-77

MISSISSIPPI
 BOARD OF WATER COMMISSIONERS
 416 North State Street
 Jackson, Mississippi 39201

WATER WELL DRILLERS LOG

1-3 1977 Hollinger Plumb Marion
 date well completed firm name county well located

LANDOWNER: Keith H. Stuvell	description of formations encountered	from	to
Rt 2			
Kokomo, Miss. (mailing address)	Red clay sand, gravel	0	18
		18	80

WELL LOCATION:
 sec. 4 T. 3(N) R. 12(E)
 5 1/2 miles N of Kokomo
 (distance) (direction) (nearest town)

WELL PURPOSE: Home
 (home, irrigation, municipal, industrial)

- WELL COMPLETION DATA:
- (1) diameter (inches) 2"
 - (2) total depth (feet) 80
 - (3) static water level (feet) 30 below top of ground.
 - (4) casing PVC, 80 (material) (depth)
 (size) if telescope see back.
 - (5) screen 5, 75 (length) (depth to top)
 2, PVC (size) (material)
 - (6) pump 1, 12 (HP) (yield gpm)
 elect (type power)
 - (7) electric log (yes or no)
 - (organization running log)
 - (8) how well bottom plugged sand
 sharp


DRILLERS REMARKS: good

RECEIVED
 JAN 20 1977

MISS. BD. OF WATER COMMISSIONERS

If well telescopes please sketch and show depths.

GROUND LEVEL

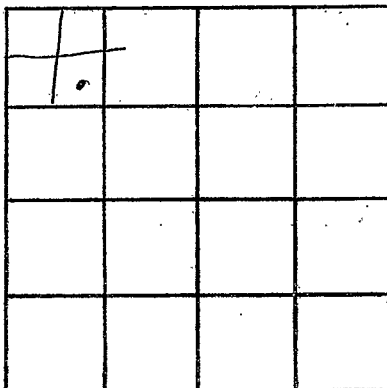

SECTION _____

Please indicate well location X.

ADDITIONAL INFORMATION

If more than one screen, show locations of each on sketch.