

MARION
 J 2014
 2-16-77

MISSISSIPPI
 BOARD OF WATER COMMISSIONERS
 416 North State Street
 Jackson, Mississippi 39201

WATER WELL DRILLERS LOG

2-16 1977 Hollinger MARION
 date well completed firm name county well located

LANDOWNER: MAR Rowley
RT1
Kokomo, Miss.
 (mailing address)

description of formations encountered

	from	to
Clay Sand	0	40
Sandy clay	40	80
Sand & gravel	80	130

WELL LOCATION:
 sec. 20 T. 3 (N) R. 12 (E)
 S W
2 1/2 miles N of Kokomo
 (distance) (direction) (nearest town)

WELL PURPOSE: Home
 (home, irrigation, municipal, industrial)

WELL COMPLETION DATA:

(1) diameter (inches) 2"
 (2) total depth (feet) 130
 (3) static water level (feet) 100 below above
 top of ground.
 (4) casing PVC
 (material) (depth)
 (size) If telescope see back.
 (5) screen 5 125
 (length) (depth to top)
2" PVC
 (size) (material)
 (6) pump 1 6
 (HP) (yield gpm)
elect
 (type power)
 (7) electric log _____
 (yes or no)

 (organization running log)
 (8) how well bottom plugged sand
SHARK

DRILLERS REMARKS: good


RECEIVED

MAR 17 1977

MISS. BD. OF WATER COMM.

If well telescopes please sketch and show depths.

GROUND LEVEL

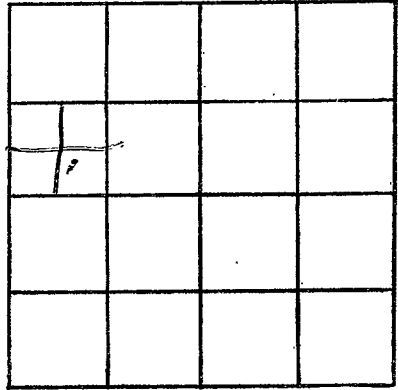

SECTION 20

Please indicate well location X.

ADDITIONAL INFORMATION

If more than one screen,
show locations of each on sketch.