

Marion
J 2016
3/15/77

MISSISSIPPI
BOARD OF WATER COMMISSIONERS
416 North State Street
Jackson, Mississippi 39201

WATER WELL DRILLERS LOG

3-15
date well completed

13V

19 77 Fitzgerald Well Ser
firm name

Marion
county well located

LANDOWNER:
James A. Regan
RR. Kokomo, Miss.
(mailing address)

description of fomations
encountered

from to

Red clay 0 20
Red sand 20 210
Coarse sand & gravel 210 222

WELL LOCATION:
sec. 27 T. 3 N R. 12 E
S W
1/2 miles E of Kokomo
(distance) (direction) (nearest town)

WELL PURPOSE: Home
(home, irrigation, municipal, industrial)

- WELL COMPLETION DATA:
- (1) diameter (inches) 4
 - (2) total depth (feet) 222
 - (3) static water level (feet) 120 below top of ground.
 - (4) casing PVC 214 (material) (depth)
4 (size) if telescope see back.
 - (5) screen 8 214 (length) (depth to top)
4 (size) PVC (material)
 - (6) pump 1/2 10 (HP) (yield gpm)
Ebe (type power)
 - (7) electric log 20 (yes or no)
 - (organization running log)
 - (8) how well bottom plugged sand & silt


DRILLERS REMARKS:

RECEIVED
MAR 20 1977

MISS. Bd. OF WATER COMMISSIONERS

If well telescopes please sketch and show depths.

GROUND LEVEL

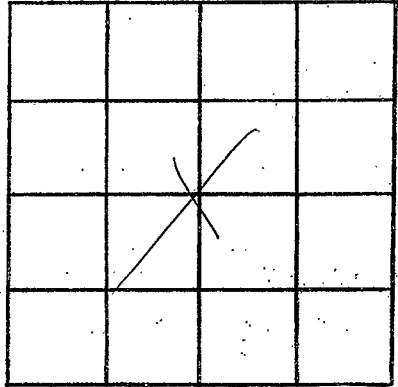

SECTION 27

Please indicate well location X.

ADDITIONAL INFORMATION

If more than one screen,
show locations of each on sketch.