

MARION
J 2017
4-14-77

MISSISSIPPI
BOARD OF WATER COMMISSIONERS
 416 North State Street
 Jackson, Mississippi 39201

WATER WELL DRILLERS LOG

4-14 19**77** Dean Plumbing & Marion Co.
 date well completed firm name Well Service county well located

LANDOWNER:

Mr. R. W. Conerly
Rt. 1 - Jopwork, Miss
 (mailing address)

description of formations encountered

from to

Top Soil	0	1
Clay	1	19
Chalk & Clay	19	35
Gravel	35	104
Chalk	104	184
SAND	184	225

WELL LOCATION:

sec. 2 3 N 12 E
5 miles N of Rakomo
 (distance) (direction) (nearest town)

WELL PURPOSE: HOME
 (home, irrigation, municipal, industrial)

WELL COMPLETION DATA:

- (1) diameter (inches) 4"
- (2) total depth (feet) 275 ft.
- (3) static water level (feet) 155 below above top of ground.
- (4) casing Plastic 25.5'
 (material) (depth)
4" If telescope see back.
 (size)
- (5) screen 20 ft. 205'
 (length) (depth to top)
4" Plastic
 (size) (material)
- (6) pump 3/4 11
 (HP) (yield gpm)
elec.
 (type power)
- (7) electric log No
 (yes or no)

(organization running log)

(8) how well bottom plugged B. W. Valve


DRILLERS REMARKS:

RECEIVED

SEP 12 1977

If well telescopes please sketch and show depths.

GROUND LEVEL

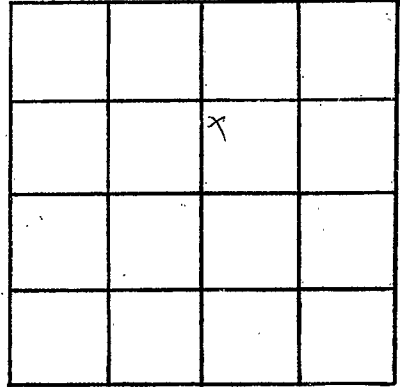

SECTION 2

Please indicate well location X.

ADDITIONAL INFORMATION

If more than one screen, show locations of each on sketch.