

#17394

MARION
J 2018
4-5-77

MISSISSIPPI
BOARD OF WATER COMMISSIONERS
416 North State Street
Jackson, Mississippi 39201

WATER WELL DRILLERS LOG

April 5 1977 date well completed
77 Denn Plumbing & Marion Co. firm name Well Service county well located

LANDOWNER:

Ms Bonnie Bean Boyd
Rt. 3 Box 228 - Forkwith, Miss.
(mailing address)

description of formations encountered

from to

Top Soil	0	1
Red Clay	1	38
Clay & gravel	38	162
Chalk	162	183
SAND	183	225

WELL LOCATION:

sec. 25 T-3 N R 20 E
6 miles SW of Columbus
(distance) (direction) (nearest town)

WELL PURPOSE: Home
(home, irrigation, municipal, industrial)

WELL COMPLETION DATA:

- (1) diameter (inches) 4"
- (2) total depth (feet) 225 ft
- (3) static water level (feet) 160 ft below top of ground
- (4) casing plastic (material) (depth)
(size) If telescope see back.
- (5) screen 20 ft (length) (depth to top)
4 in plastic (size) (material)
- (6) pump 3/4 HP 10 gals Min (HP) (yield gpm) etc
Elec. (type power)
- (7) electric log (yes or no)
(organization running log)

(8) how well bottom plugged Back wash valve

DRILLERS REMARKS:


RECEIVED

SEP 12 1977

MISS. BD. OF WATER COMM.

If well telescopes please sketch and show depths.

GROUND LEVEL

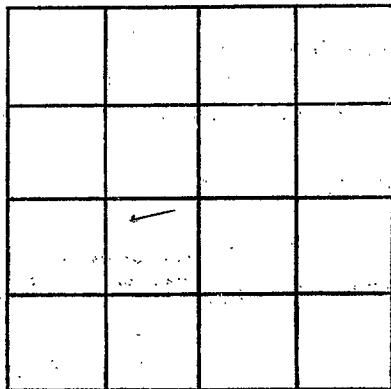

SECTION 25

Please indicate well location X.

ADDITIONAL INFORMATION

If more than one screen, show locations of each on sketch.