

MARION
 J 2019
 May 30, 1977

MISSISSIPPI
 BOARD OF WATER COMMISSIONERS
 416 North State Street
 13V Jackson, Mississippi 39201

(55)

WATER WELL DRILLERS LOG

May 30 1977 *Reems Well Dr* *Marion*
 date well completed firm name county well located

LANDOWNER:
Jerry Pittman
At 1 No Nono
 (mailing address)

description of formations encountered	from	to
<i>clay</i>	<i>0</i>	<i>12</i>
<i>red sand</i>	<i>12</i>	<i>40</i>
<i>sandy & chalk</i>	<i>120</i>	<i>84</i>
<i>sub pebbles gravel</i>	<i>84</i>	<i>102</i>

WELL LOCATION:
 sec. 2 T. 3 N R. 12 E
 miles of (distance) (direction) (nearest town)

WELL PURPOSE: *home*
 (home, irrigation, municipal, industrial)

- WELL COMPLETION DATA:
- (1) diameter (inches) 4"
 - (2) total depth (feet) 102
 - (3) static water level (feet) 15 below top of ground.
 - (4) casing plastic bottom
 (material) (depth)
 - (5) screen 5' 99'
 (length) (depth to top)
 - (6) pump 4' plastic
 (size) (material)
 - (7) pump by others
 (HP) (yield gpm.)
 - (8) electric log elect
 (type power)
 - (9) electric log no
 (yes or no)
 - (10) (organization running log)

(8) how well bottom plugged
wooden plug


DRILLERS REMARKS:

RECEIVED
 AUG 26 1977

MISS. BD. OF WATER COMMISSIONERS

If well telescopes please sketch and show depths.

GROUND LEVEL

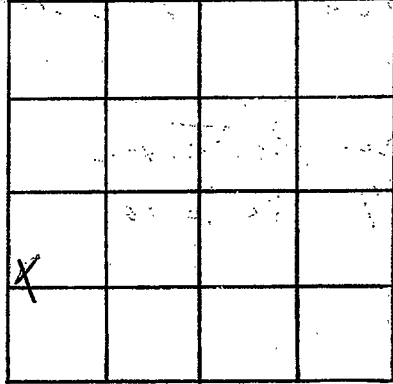

SECTION 2

Please indicate well location X.

ADDITIONAL INFORMATION

If more than one screen, show locations of each on sketch.