

MARION  
 J 2020  
 6/22/77

MISSISSIPPI  
 BOARD OF WATER COMMISSIONERS  
 416 North State Street  
 Jackson, Mississippi 39201

WATER WELL DRILLERS LOG

6/22 1977 <sup>132</sup> Hollinsin Marion  
 date well completed firm name county well located

LANDOWNER: ~~Johnston~~  
 Woodrow Morris  
 Rt 1 Kokomo, Miss  
 (mailing address)

description of formations encountered	from	to
Clay gravel	0	16
Chert	16	50
Sand	50	100

WELL LOCATION: 12  
 sec. 13 T 30 N R 7 E  
 6 miles W of Foxworth  
 (distance) (direction) (nearest town)

WELL PURPOSE: Home  
 (home, irrigation, municipal, industrial)


- WELL COMPLETION DATA:
- (1) diameter (inches) 2"
  - (2) total depth (feet) 100
  - (3) static water level (feet) 16 <sup>below</sup> ~~above~~ top of ground.
  - (4) casing PVC, 95  
 (material) (depth)  
 (size) if telescope see back.
  - (5) screen 5, 95  
 (length) (depth to top)  
 2" PVC  
 (size) (material)
  - (6) pump 1/2, 10  
 (HP) (yield gpm)  
 elect  
 (type power)
  - (7) electric log (yes or no)
  - (organization running log)
  - (8) how well bottom plugged sand  
 sharp

DRILLERS REMARKS: good well

RECEIVED  
 JUL 11 1977

If well telescopes please sketch and show depths.

GROUND LEVEL

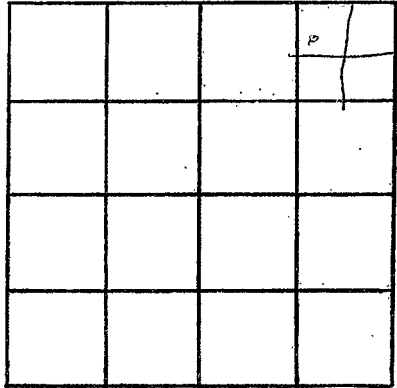

SECTION 13

Please indicate well location X.

ADDITIONAL INFORMATION

If more than one screen,  
show locations of each on sketch.