

Marion
J 2021
8/19/77

MISSISSIPPI
BOARD OF WATER COMMISSIONERS
416 North State Street
132 Jackson, Mississippi 39201

WATER WELL DRILLERS LOG

8/19 1977 Hallinsworth Well Marion
date well completed firm name county well located

LANDOWNER: Carl Bunkerfeld
RT 1
Kokomo Miss
(mailing address)

description of formations encountered	from	to
	clay	0
CHALK	20	30
sand, gravel	30	75

WELL LOCATION:
sec. 17 T. 3 (N) R. 12 (E)
62 1/2 miles N of Kokomo
(distance) (direction) (nearest town)

WELL PURPOSE: Home
(home, irrigation, municipal, industrial)

- WELL COMPLETION DATA:
- (1) diameter (inches) 4"
 - (2) total depth (feet) 75
 - (3) static water level (feet) 30 below above top of ground.
 - (4) casing pvc, 65
(material) (depth)
(size) If telescope see back.
 - (5) screen 10, 65
(length) (depth to top)
4", pvc
(size) (material)
 - (6) pump 1, 15
(HP) (yield gpm)
elect
(type power)
 - (7) electric log _____
(yes or-no)

(organization running log)
 - (8) how well bottom plugged sand
shark


DRILLERS REMARKS: good well

RECEIVED

SEP 13 1977

If well telescopes please sketch and show depths.

GROUND LEVEL

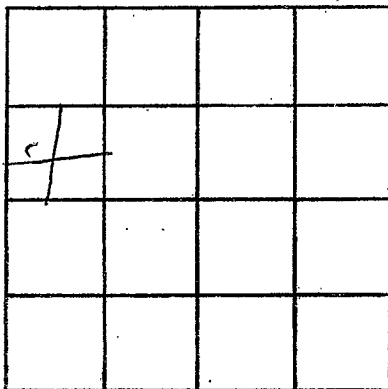

SECTION 17

Please indicate well location X.

ADDITIONAL INFORMATION

If more than one screen, show locations of each on sketch.