

Marion
 J 2022
 9/9/77

MISSISSIPPI
 BOARD OF WATER COMMISSIONERS
 416 North State Street
 Jackson, Mississippi 39201

WATER WELL DRILLERS LOG

Sept. 9 1977 Dean Well Service Marion
 date well completed firm name county well located

LANDOWNER:
Mr. Julius Hammond
Kokomo, Miss.
 (mailing address)

WELL LOCATION:
 sec. 21 T. 3 N. R. 12 E.
 S. W.
4 miles N of Kokomo
 (distance) (direction) (nearest town)

WELL PURPOSE: Home
 (home, irrigation, municipal, industrial)

WELL COMPLETION DATA:
 (1) diameter (inches) 2"
 (2) total depth (feet) 160 ft
 (3) static water level (feet) 100 below above top of ground.
 (4) casing Plastic, 150 ft.
 (material) (depth)
2"
 (size) if telescope see back.
 (5) screen 10 ft., 150 ft.
 (length) (depth to top)
2", Plastic
 (size) (material)
 (6) pump 1 10
 (HP) (yield gpm)
Elec
 (type power)
 (7) electric log no
 (yes or no)
 (organization running log)
 (8) how well bottom plugged
B. w. Valve


description of formations encountered	from	to
Top Soil	0	1
Clay	1	28
clay & gravel	28	41
Chalk	41	104
Shale	104	112
Chalk	112	128
SAND	128	160

RECEIVED
 DEC 16 1977
 MISS. BO. OF WATER COM.

DRILLERS REMARKS:

If well telescopes please sketch and show depths.

GROUND LEVEL

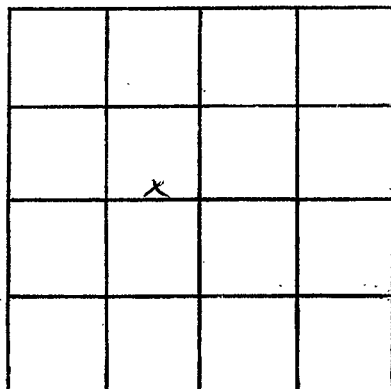

SECTION 21

Please indicate well location X.

ADDITIONAL INFORMATION

If more than one screen, show locations of each on sketch.