

MARION  
 J 2023  
 10/21/77

MISSISSIPPI  
 BOARD OF WATER COMMISSIONERS  
 416 North State Street  
 Jackson, Mississippi 39201

WATER WELL DRILLERS LOG

10-21 1977 Filwood Well Service Marion  
 date well completed firm name county well located

LANDOWNER:  
 Robert Hilton  
 R.R. Kalamo  
 (mailing address)

description of formations encountered	from	to
Red Clay	0	20
Red sand	20	80
Red gravel	80	120
Coarse sand & gravel	120	136

WELL LOCATION:  
 sec. 32 T-3 N R-12 E  
 1 miles NW of Kalamo  
 (distance) (direction) (nearest town)

WELL PURPOSE:  
 Home  
 (home, irrigation, municipal, industrial)

- WELL COMPLETION DATA:
- (1) diameter (inches) 4
  - (2) total depth (feet) 136
  - (3) static water level (feet) 75 below above top of ground.
  - (4) casing PVC, 128, (material) (depth)  
 4 (size) if telescope see back.
  - (5) screen 8, 128 (length) (depth to top)  
 4 (size) PVC (material)
  - (6) pump 1/2, 10 (HP) (yield gpm)  
 Elec (type power)
  - (7) electric log yes (yes or no)  
 (organization running log)
  - (8) how well bottom plugged Sealed

RECEIVED


OCT 31 1977

MISS. BD. OF WATER COM.

DRILLERS REMARKS:

If well telescopes please sketch and show depths.

GROUND LEVEL

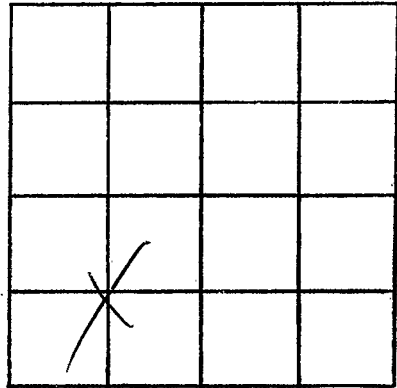

SECTION 32

Please indicate well location X.

ADDITIONAL INFORMATION

If more than one screen,  
show locations of each on sketch.