

MARION
 J 2024
 10/26/77

MISSISSIPPI
 BOARD OF WATER COMMISSIONERS
 416 North State Street
 Jackson, Mississippi 39201

WATER WELL DRILLERS LOG

10/26 1977 Hollinger Well Serv MARION
 date well completed firm name county well located

LANDOWNER: Lou Mice Holmes
 RT 1
 Kokomo, Ms.
 (mailing address)

description of formations encountered	from	to
Clay, gravel, chert sand	0 40	40 65

WELL LOCATION:
 sec 24 T 3 N R 12 E
 5 miles W of Foxworth
 (distance) (direction) (nearest town)

WELL PURPOSE: Home
 (home, irrigation, municipal, industrial)

WELL COMPLETION DATA:
 (1) diameter (inches) 2"
 (2) total depth (feet) 65 ft.
 (3) static water level (feet) 40 below above top of ground.
 (4) casing pvc 60 (material) (depth)
 (size) If telescope see back.
 (5) screen 5 60 (length) (depth to top)
 2" pvc (size) (material)
 (6) pump 1/2 7 (HP) (yield gpm)
 elect (type power)
 (7) electric log (yes or no)
 (organization running log)
 (8) how well bottom plugged sand SHARK

DRILLERS REMARKS: very good well


RECEIVED

NOV 30 1977

MISS. Bd. OF WATER COMMISSIONERS

If well telescopes please sketch and show depths.

GROUND LEVEL

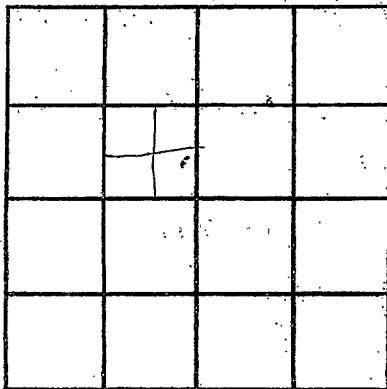

SECTION 24

Please indicate well location X.

ADDITIONAL INFORMATION

If more than one screen, show locations of each on sketch.