

Marion
 J 2025
 12/22/78

MISSISSIPPI
 BOARD OF WATER COMMISSIONERS
 416 North State Street
 Jackson, Mississippi 39201

WATER WELL DRILLERS LOG

12-22 1978
 date well completed

J. D. Dinn Well Service Marion
 firm name county well located

LANDOWNER:

Mr. Lawrence Beard
 Rt. 3, Jopworth, Miss.
 (mailing address)

description of formations encountered

from to

Top Soil	0	1
Clay	1	13
Clay-gravel	13	38
Chalk	38	104
Rock	104	106
Chalk	106	168
Sand	168	220

WELL LOCATION:

12E
 sec. 26 T. 3 N R. 22 E
 3 miles E of Kokomo
 (distance) (direction) (nearest town)

WELL PURPOSE: Home
 (home, irrigation, municipal, industrial)

WELL COMPLETION DATA:

- (1) diameter (inches) 4"
- (2) total depth (feet) ~~220~~ ft 220
- (3) static water level (feet) ~~220~~ above top of ground. 150
- (4) casing Plastic 200ft
 (material) (depth)
 4" if telescope see back.
 (size)
- (5) screen 20ft., 200ft.
 (length) (depth to top)
 4" Plastic
 (size) (material)
- (6) pump 1 HP
 (HP) (yield gpm)
 Elec
 (type power)
- (7) electric log No
 (yes or no)

(organization running log)

(8) how well bottom plugged
 B. W. Value


DRILLERS REMARKS:

RECEIVED
 MAR - 2 1978

MISS. BD. OF WATER COMMISSIONERS

If well telescopes please sketch and show depths.

GROUND LEVEL

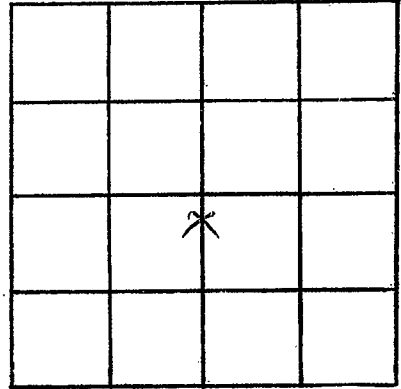

SECTION 26

Please indicate well location X.

ADDITIONAL INFORMATION

If more than one screen, show locations of each on sketch.