

Marion
 J 2027
 W/11/78

MISSISSIPPI
 BOARD OF WATER COMMISSIONERS
 416 North State Street
 Jackson, Mississippi 39201

WATER WELL DRILLERS LOG

Nov. 11 1978 date well completed
 Dinn Plumbing Marion firm name
 Marion county well located

LANDOWNER:
 Mr. John L. Lee
 Kokomo, Miss.
 (mailing address)

description of formations encountered	from	to
TOP SOIL	0	1
CLAY	1	18
CHALK	18	64
SAND	64	100

WELL LOCATION:
 sec 28 T 3 N R 12 E
 1 miles E of Kokomo
 (distance) (direction) (nearest town)

WELL PURPOSE: HOME
 (home, irrigation, municipal, industrial)

- WELL COMPLETION DATA:
- (1) diameter (inches) 2"
 - (2) total depth (feet) 100 ft.
 - (3) static water level (feet) 40 ft. below top of ground.
 - (4) casing plastic, 80 ft. (material) (depth)
 2" (size) if telescope see back.
 - (5) screen 20 ft, 80 ft (length) (depth to top)
 2" plastic (size) (material)
 - (6) pump 1 (HP) (yield gpm)
 Elec. (type power)
 - (7) electric log no (yes or no)
 - (organization running log)
 - (8) how well bottom plugged B.W. Value


DRILLERS REMARKS:

RECEIVED
 MAR - 2 1978

MISS. BD. OF WATER COMMISSIONERS

If well telescopes please sketch and show depths.

GROUND LEVEL

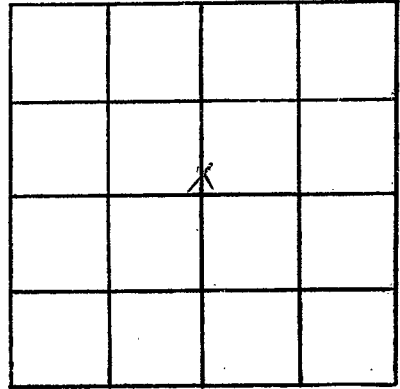

SECTION 28

Please indicate well location X.

ADDITIONAL INFORMATION

If more than one screen, show locations of each on sketch.