

MARION
 J 2028
 1/16/78

MISSISSIPPI
 BOARD OF WATER COMMISSIONERS
 416 North State Street
 Jackson, Mississippi 39201

WATER WELL DRILLERS LOG

Jan - 16 1978 Tom Griffith Plumbing Marion
 date well completed firm name Well Service county well located

LANDOWNER:
 Mr. W. L. Dixon
 P.O. Box 724 - Columbia, Miss
 (mailing address)

description of formations encountered	from	to
Top Soil	0	2
Clay	2	20
Clay	20	90
Sand	90	100

WELL LOCATION:
 sec. 1 T. 3 N. R. 12 E.
 S. W.
 4 miles W of Fawcett
 (distance) (direction) (nearest town)

WELL PURPOSE: Home
 (home, irrigation, municipal, industrial)


- WELL COMPLETION DATA:
- (1) diameter (inches) 2"
 - (2) total depth (feet) 100 ft
 - (3) static water level (feet) 143 ft below top of ground.
 - (4) casing Plastic 90 ft.
 (material) (depth)
 2" If telescope see back.
 (size)
 - (5) screen 10 ft, 90 ft.
 (length) (depth to top)
 2" Plastic
 (size) (material)
 - (6) pump 1 HP 5
 (HP) (yield gpm)
 Electric
 (type power)
 - (7) electric log no
 (yes or no)
- (organization running log)
- (8) how well bottom plugged B.W. Valve

DRILLERS REMARKS:

RECEIVED
 MAR 31 1978
 MISS. BD. OF WATER COM.

If well telescopes please sketch and show depths.

GROUND LEVEL

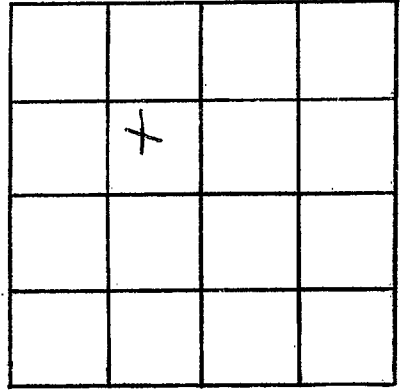

SECTION _____

Please indicate well location X.

ADDITIONAL INFORMATION

If more than one screen,
show locations of each on sketch.