

MARION
 J 2029
 2-3-18

MISSISSIPPI
 BOARD OF WATER COMMISSIONERS
 416 North State Street
 Jackson, Mississippi 39201

WATER WELL DRILLERS LOG

Feb-3 1978 Don Griffith Well Marion
 date well completed well name county well located
Service

LANDOWNER:
Mr. Garland Stephenson
Kokomo, Miss.
 (mailing address)

description of formations encountered	from	to
<u>top soil</u>	<u>0</u>	<u>2</u>
<u>clay</u>	<u>2</u>	<u>20</u>
<u>gravel</u>	<u>20</u>	<u>35</u>
<u>sand & gravel</u>	<u>35</u>	<u>40</u>

WELL LOCATION:
 sec. 13 T 3 N R 12 E
7 miles W of Clumbia
 (distance) (direction) (nearest town)

WELL PURPOSE: house
 (home, irrigation, municipal, industrial)


- WELL COMPLETION DATA:
- (1) diameter (inches) 4"
 - (2) total depth (feet) 80 ft.
 - (3) static water level (feet) _____ below/above top of ground.
 - (4) casing plastic, 70 ft.
 (material) (depth)
4" if telescope see back.
 (size)
 - (5) screen 10 ft., 70 ft.
 (length) (depth to top)
4" plastic
 (size) (material)
 - (6) pump 3/4 HP
 (HP) (yield gpm)
Electric
 (type power)
 - (7) electric log no
 (yes or no)
n/a
 (organization running log)
 - (8) how well bottom plugged
B.W. Valve

DRILLERS REMARKS:

RECEIVED
 APR 27 1978

MISS. BD. OF WATER COMM

GROUND LEVEL

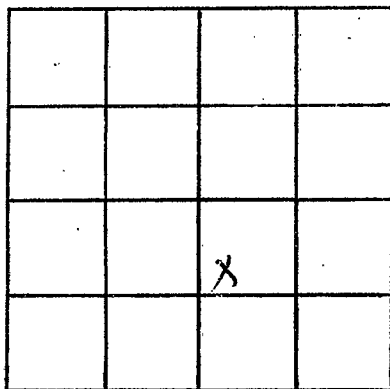

SECTION 13

Please indicate well location X.

ADDITIONAL INFORMATION

If more than one screen,
show locations of each on sketch.