

MARION

J 2031

4-18-78

MISSISSIPPI BOARD OF WATER COMMISSIONERS 416 North State Street Jackson, Mississippi 39201

WATER WELL DRILLERS LOG

4/18

1978

Holliman Wells

MARION

date well completed

firm name

county well located

LANDOWNER: Dirl Brall

Diral

Hwy 586

Forworth, MS (mailing address)

description of formations encountered

from

to

CLAY SAND, GRAVEL

0 30 30 87

WELL LOCATION:

sec. 31 T 30 N R 20 S 7 miles W of Forworth

WELL PURPOSE: Home (home, irrigation, municipal, industrial)

WELL COMPLETION DATA:

- (1) diameter (inches) 2"
(2) total depth (feet) 87
(3) static water level (feet) 30 below above top of ground.
(4) casing PVC 82 (material) (depth)
(5) screen 5 82 (length) (depth to top)
(6) pump 1 (HP) (yield gpm)
(7) electric log (yes or no)

(organization running log) SAND SHANK very good well


DRILLERS REMARKS: good

RECEIVED MAY 8 - 1978

MISS. BD. OF WATER COMMISSIONERS

If well telescopes please sketch and show depths.

GROUND LEVEL

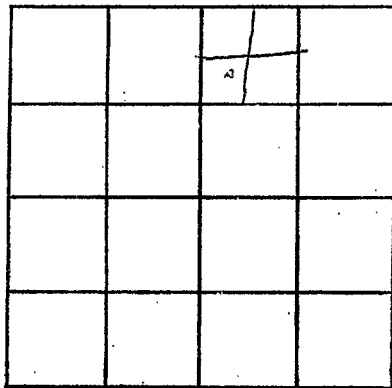

SECTION 11

Please indicate well location X.

ADDITIONAL INFORMATION

If more than one screen,
show locations of each on sketch.