

MARION
KJ
 5/18 2033

MISSISSIPPI
 BOARD OF WATER COMMISSIONERS
 416 North State Street
 Jackson, Mississippi 39201

WATER WELL DRILLERS LOG

May 19 *78* *Tom Griffith* PLUMBING & WELL SERVICE, INC. *Marion*
 date well completed *320 MARION AVE.* county well located
COLUMBIA, MS 39429

LANDOWNER:
Dorothy Harvey
P.O. Box 63 - Kokomo
 (mailing address) *Miss*

description of formations encountered	from	to
<i>top soil</i>	<i>0</i>	<i>1</i>
<i>Clay</i>	<i>1</i>	<i>20</i>
<i>Clay</i>	<i>20</i>	<i>75</i>
<i>Sand</i>	<i>75</i>	<i>100</i>

WELL LOCATION:
 sec. *21* T. *30* S. R. *12E*
1 miles *N* of *Kokomo*
 (distance) (direction) (nearest town)

WELL PURPOSE: *Home*
 (home, irrigation, municipal, industrial)

- WELL COMPLETION DATA:
- (1) diameter (inches) *2"*
 - (2) total depth (feet) *100 ft*
 - (3) static water level (feet) *140 ft* below top of ground.
 - (4) casing *Plastic* *90 ft*
(material) (depth)
2"
(size) If telescope see back.
 - (5) screen *10 ft* *90 ft*
(length) (depth to top)
2" *Plastic*
(size) (material)
 - (6) pump *1 hp* *10*
(HP) (yield gpm)
Electric
(type power)
 - (7) electric log *no*
(yes or no)
- (organization running log)
- (8) how well bottom plugged *Back Wash Valve*

RECEIVED


JUN 30 1978

DRILLERS REMARKS:

MISS. BD. OF WATER COMM.

If well telescopes please sketch and show depths.

GROUND LEVEL

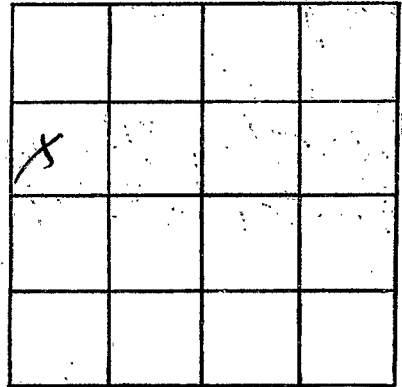

SECTION 21

Please indicate well location X.

ADDITIONAL INFORMATION

If more than one screen,
show locations of each on sketch.