

MARION
J
2035

**MISSISSIPPI  
BOARD OF WATER COMMISSIONERS**  
416 North State Street  
Jackson, Mississippi 39201

**WATER WELL DRILLERS LOG**

5/17/78 19 Hollinger Well Service Marion  
 date well completed                      firm name                      county well located

LANDOWNER: Sec Childs  
RT1 Kokomo, Ms  
 (mailing address)

description of formations encountered	from	to
<u>clay &amp; gravel</u>	<u>0</u>	<u>50</u>
<u>peat gravel</u>	<u>50</u>	<u>100</u>

WELL LOCATION:  
 sec. 4 T 3 (N) R 12 (E)  
2 1/2 miles S of Kokomo  
 (distance) (direction) (nearest town)

WELL PURPOSE: Home  
 (home, irrigation, municipal, industrial)

WELL COMPLETION DATA:

(1) diameter (inches) 4

(2) total depth (feet) 100

(3) static water level (feet) 50 below above top of ground.

(4) casing PVC 95  
 (material) (depth)

(size) if telescope see back.

(5) screen 5 95  
 (length) (depth to top)

4 PVC  
 (size) (material)

(6) pump 3/4 15  
 (HP) (yield gpm)

elect.  
 (type power)

(7) electric log \_\_\_\_\_  
 (yes or no)

\_\_\_\_\_  
 (organization running log)


(8) how well bottom plugged sand  
SHARK

DRILLERS REMARKS: good well

**RECEIVED**  
 JUL 23 1978  
 MISS. BD. OF WATER COMMISSIONERS

If well telescopes please sketch and show depths.

GROUND LEVEL

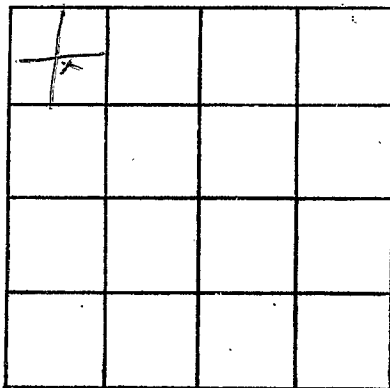

SECTION 4

Please indicate well location X.

ADDITIONAL INFORMATION

If more than one screen,  
show locations of each on sketch.