

MARION
 J 2036
 5-25-78

MISSISSIPPI
 BOARD OF WATER COMMISSIONERS
 416 North State Street
 Jackson, Mississippi 39201

WATER WELL DRILLERS LOG

5/25 19 78 TOM GRIFFITH
 date well completed PLUMBING & WELL SERVICE, INC. Marion
 county well located

LANDOWNER:
 Mr. Eugene Ryals
 Rt. 1 - Kokomo
 (mailing address)

description of formations encountered	from	to
top soil	0	1
Clay	1	20
Clay	20	30
sand	30	115

WELL LOCATION:
 sec. 35 T 30 N R 12 E
 3 miles E of Kokomo
 (distance) (direction) (nearest town)

WELL PURPOSE: none
 (home, irrigation, municipal, industrial)

- WELL COMPLETION DATA:
- (1) diameter (inches) 2"
 - (2) total depth (feet) 115 ft
 - (3) static water level (feet) _____ below/above top of ground.
 - (4) casing plastic, 105 ft (material) (depth)
 2" (size) if telescope see back.
 - (5) screen 10 ft, 105 ft (length) (depth to top)
 2" plastic (size) (material)
 - (6) pump 1 HP, 10 (HP) (yield gpm)
 Electric (type power)
 - (7) electric log No (yes or no)

(organization running log)

(8) how well bottom plugged Back Wash Valve

DRILLERS REMARKS:


RECEIVED

JUN 30 1978

MISS. BD. OF WATER COMM

If well telescopes please sketch and show depths.

GROUND LEVEL

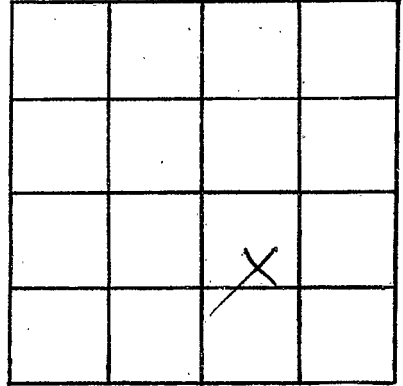

SECTION 35

Please indicate well location X.

ADDITIONAL INFORMATION

If more than one screen,
show locations of each on sketch.