

MARION  
 J 2037  
 6-4-78

MISSISSIPPI  
 BOARD OF WATER COMMISSIONERS  
 416 North State Street  
 Jackson, Mississippi 39201

WATER WELL DRILLERS LOG

6-4 1978 *Flynn & Sons* Marion  
 date well completed firm name county well located

LANDOWNER:	description of formations encountered	from	to
<i>Holland Opton</i>			
<i>R.R. Kerkemo, SWS</i> (mailing address)	<i>Red clay</i>	<i>0</i>	<i>20</i>
	<i>Red sand</i>	<i>20</i>	<i>150</i>
	<i>Coarse sand &amp; gravel</i>	<i>150</i>	<i>160</i>
WELL LOCATION: sec. <i>28</i> T. <i>3</i> N. R. <i>12</i> E <i>1/2</i> miles <i>E</i> of <i>Kerkemo</i> (distance) (direction) (nearest town)			
WELL PURPOSE: <i>Home</i> (home, irrigation, municipal, industrial)			
WELL COMPLETION DATA:			
(1) diameter (inches) <i>4</i>			
(2) total depth (feet) <i>160</i>			
(3) static water level (feet) <i>110</i> below top of ground.			
(4) casing <i>PVC, 152</i> (material) (depth)			
<i>4</i> (size) if telescope see back.			
(5) screen <i>8, 152</i> (length) (depth to top)			
<i>4</i> (size) <i>PVC</i> (material)			
(6) pump <i>1/2, 8</i> (HP) (yield gpm)			
<i>4</i> (type power)			
(7) electric log <i>no</i> (yes or no)			
(organization running log)			
(8) how well bottom plugged <i>Sealed</i>			


RECEIVED  
 JUN 23 1978

DRILLERS REMARKS:

MISS. BD. OF WATER COMMISSIONERS

If well telescopes please sketch and show depths.

GROUND LEVEL

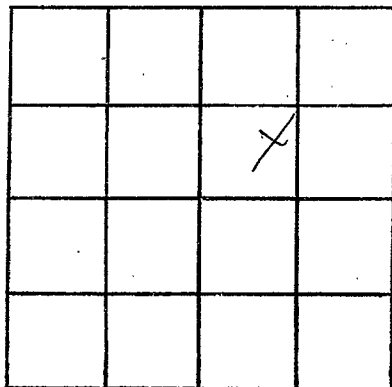

SECTION 28

Please indicate well location X.

ADDITIONAL INFORMATION

If more than one screen,  
show locations of each on sketch.