

MARION
 J 238
 6-12-78

MISSISSIPPI
 BOARD OF WATER COMMISSIONERS
 416 North State Street
 Jackson, Mississippi 39201

WATER WELL DRILLERS LOG

June 12 1978 *Revere Wellser* *Marion*
 date well completed firm name county well located


LANDOWNER:	description of formations encountered	from	to
<i>Carol Quinn</i>	<i>Red clay</i>	0	18
<i>Rt Columbia</i> (mailing address)	<i>Red sand</i>	18	63
WELL LOCATION: sec. <i>24 7</i> N R <i>12 E</i> S	<i>White Chalk</i>	63	110
<i>3</i> miles <i>ESE</i> of <i>Foreman</i> (distance) (direction) (nearest town)	<i>Coarse sand</i>	110	142
WELL PURPOSE: <i>shop</i> (home, irrigation, municipal, industrial)			
WELL COMPLETION DATA:			
(1) diameter (inches) <i>4"</i>			
(2) total depth (feet) <i>142</i>			
(3) static water level (feet) <i>90</i> below top of ground. above			
(4) casing <i>plastic bottom</i> (material) (depth)			
_____ if telescope see back. (size)			
(5) screen <i>5'</i> <i>139'</i> (length) (depth to top)			
<i>4"</i> <i>plastic</i> (size) (material)			
(6) pump <i>1/2</i> <i>10</i> (HP) (yield gpm)			
<i>1/2</i> (type power)			
(7) electric log <i>no</i> (yes or no)			
_____ (organization running log)			
(8) how well bottom plugged <i>no water plug</i>			
DRILLERS REMARKS:			

RECEIVED
 OCT 25 1978

MISS. BD. OF WATER COMMISSIONERS

If well telescopes please sketch and show depths.

GROUND LEVEL

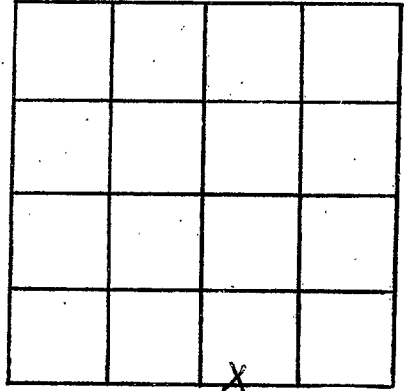

SECTION 24

Please indicate well location X.

ADDITIONAL INFORMATION

If more than one screen, show locations of each on sketch.