

MARION
 J 2039
 6-13-78

MISSISSIPPI
 BOARD OF WATER COMMISSIONERS
 416 North State Street
 Jackson, Mississippi 39201

WATER WELL DRILLERS LOG

6-13 1978 *Fitzgerald* *Marion*
 date well completed firm name county well located

LANDOWNER:	description of formations encountered	from	to
<i>Mortice Ingram</i>			
<i>R.R. Kahon</i> (mailing address)	<i>Red clay</i>	<i>0</i>	<i>20</i>
	<i>Red SAND</i>	<i>20</i>	<i>170</i>
	<i>Coarse sand & gravel</i>	<i>170</i>	<i>188</i>
WELL LOCATION:			
sec. <i>28</i> T <i>3</i> N R <i>12</i> E S W			
<i>1/4</i> miles <i>E</i> of <i>Rehoma</i> (distance) (direction) (nearest town)			
WELL PURPOSE: <i>Home</i> (home, irrigation, municipal, industrial)			
WELL COMPLETION DATA:			
(1) diameter (inches) <i>4</i>			
(2) total depth (feet) <i>188</i>			
(3) static water level (feet) <i>70</i> below top of ground.			
(4) casing <i>PVC</i> , <i>180</i> , (material) (depth)			
<i>4</i> (size) if telescope see back.			
(5) screen <i>2</i> , <i>180</i> (length) (depth to top)			
<i>4</i> , <i>PVC</i> (size) (material)			
(6) pump <i>1/2</i> , <i>10</i> (HP) (yield gpm)			
<i>Fla</i> (type power)			
(7) electric log <i>no</i> (yes or no)			
(organization running log)			
(8) how well bottom plugged <i>Paul</i>			


RECEIVED

JUN 23 1978

DRILLERS REMARKS:

If well telescopes please sketch and show depths.

GROUND LEVEL

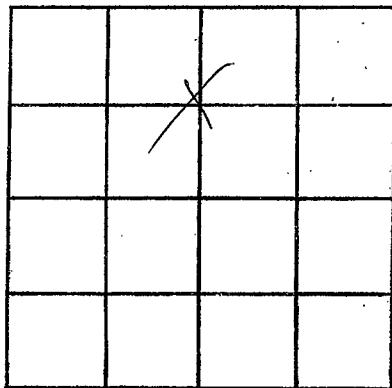

SECTION 28

Please indicate well location X.

ADDITIONAL INFORMATION

If more than one screen,
show locations of each on sketch.