

MARION

J 2041

7-15-78

MISSISSIPPI BOARD OF WATER COMMISSIONERS  
416 North State Street  
Jackson, Mississippi 39201

WATER WELL DRILLERS LOG

July 15 1978 Reiner Well Co Marion  
date well completed firm name county well located

LANDOWNER:

Jack Holmes  
Rt 1 Kokomo  
(mailing address)

description of formations encountered

from to

Red sand clay 0 26  
fine sand & gravel 26 97  
shaly 97 118  
pink chalk 118 135  
sand & gravel 135 150

WELL LOCATION:

sec. 9 T. 3 N R. 12 E

1 1/2 miles North of Kokomo  
(distance) (direction) (nearest town)

WELL PURPOSE: home  
(home, irrigation, municipal, industrial)

WELL COMPLETION DATA:

- (1) diameter (inches) 4"
- (2) total depth (feet) 150
- (3) static water level (feet) 90 below above top of ground.
- (4) casing plastic bottom  
(material) (depth)

         if telescope see back.  
(size)

- (5) screen 5' 145  
(length) (depth to top)

4" plastic  
(size) (material)

- (6) pump gas motor  
(HP) (yield gpm)


shut  
(type power)

- (7) electric log no  
(yes or no)

          
(organization running log)

- (8) how well bottom plugged wooden plug

DRILLERS REMARKS:  
old well bit  
by sitting

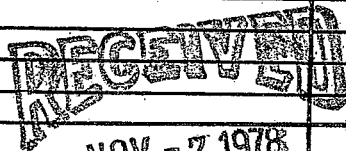


NOV - 7 1978

MISS. BD. OF WATER COMMISSIONERS

If well telescopes please sketch and show depths.

GROUND LEVEL

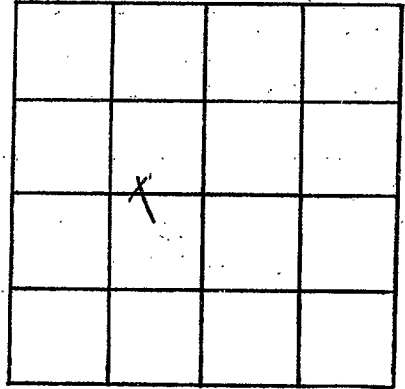

SECTION 9

Please indicate well location X.

ADDITIONAL INFORMATION

If more than one screen, show locations of each on sketch.