

MARION
J 2042
7-15-78

MISSISSIPPI
 BOARD OF WATER COMMISSIONERS
 416 North State Street
 Jackson, Mississippi 39201

WATER WELL DRILLERS LOG

July 15 1978 Reems well Marion
 date/well completed firm name county well located

LANDOWNER:
Mrs. Sidge Milford
Rt 1 Popworth
 (mailing address)

description of formations encountered	from	to
<u>Red Clay</u>	<u>0</u>	<u>25</u>
<u>Sand + gravel</u>	<u>25</u>	<u>72</u>
<u>blue Chalk</u>	<u>72</u>	<u>117</u>
<u>Sand</u>	<u>117</u>	<u>140</u>

WELL LOCATION:
 sec. Q1 T 3 N R 12 E
4 1/2 miles north of Nobles
 (distance) (direction) (nearest town)

WELL PURPOSE: home
 (home, irrigation, municipal, industrial)

- WELL COMPLETION DATA:
- diameter (inches) 4"
 - total depth (feet) 140
 - static water level (feet) 85 below/above top of ground.
 - casing plastic (material) 6' to top (depth)
 - screen 5" (length) 135" (depth to top)
 - pump 1/2 (HP) 10 (yield gpm)
elect (type power)
 - electric log NO (yes or no)
- (organization running log)
- (8) how well bottom plugged _____


DRILLERS REMARKS:

RECEIVED
 NOV - 7 1978

MISS. BD. OF WATER COMMISSIONERS

If well telescopes please sketch and show depths.

GROUND LEVEL

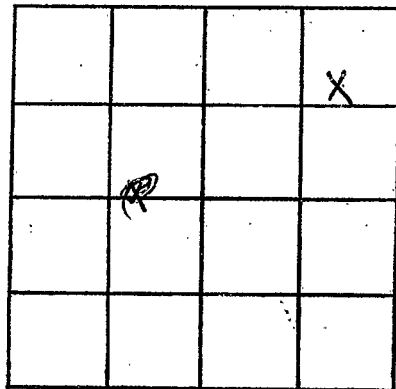

SECTION 01

Please indicate well location X.

ADDITIONAL INFORMATION

If more than one screen,
show locations of each on sketch.