

MARION
 # 2044
 11-06-78

MISSISSIPPI
 BOARD OF WATER COMMISSIONERS
 416 North State Street
 Jackson, Mississippi 39201

WATER WELL DRILLERS LOG

Nov 6 1978 News Well Inc Marion
 date well completed firm name county well located

LANDOWNER: Hammer Hance
 Rt 1 box 166 Kokomo
 (mailing address)

description of formations encountered	depth	
	from	to
clay	0	10
sand	10	45
gravel sand	45	57

WELL LOCATION:
 sec 22 T 3 N R 12 E
 3 miles N-NE of Kokomo
 (distance) (direction) (nearest town)

WELL PURPOSE: home
 (home, irrigation, municipal, industrial)

- WELL COMPLETION DATA:
- (1) diameter (inches) 4"
 - (2) total depth (feet) 57
 - (3) static water level (feet) 12 below above top of ground
 - (4) casing plastic, bottom
 (material) (depth)
 - if telescope see back.
 (size)
 - (5) screen 5' 52'
 (length) (depth to top)
 - 4" plastic
 (size) (material)
 - (6) pump by others
 (HP) (yield gpm)
 - elect
 (type power)
 - (7) electric log no
 (yes or no)
 - (organization running log)


(8) how well bottom plugged
wooden plug

DRILLERS REMARKS:

Miss. Board of Water Comm.
 FEB 15 1979
 RECEIVED

If well telescopes please sketch and show depths.

GROUND LEVEL

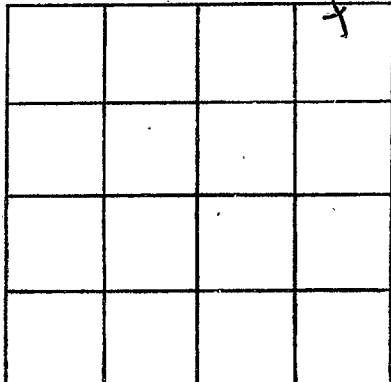

SECTION 22

Please indicate well location X.

ADDITIONAL INFORMATION

If more than one screen, show locations of each on sketch.