

MARION

J 2045

12-18-78

MISSISSIPPI
BOARD OF WATER COMMISSIONERS
416 North State Street
Jackson, Mississippi 39201

WATER WELL DRILLERS LOG

12/18

19

78 Hollinsie Well Service

MARION

date well completed

firm name

county well located

LANDOWNER: Henry Husband

description of formations encountered

from

to

RT1 Darden

CHALK

0

20

Foxworth, MS
(mailing address)

SAND

20

50

SANDY GRAVEL

50

80

WELL LOCATION:

sec. 4 T. 3 N R. 20 E 12

9 miles W of Foxworth
(distance) (direction) (nearest town)

WELL PURPOSE: Home
(home, irrigation, municipal, industrial)

WELL COMPLETION DATA:

- (1) diameter (inches) 2"
- (2) total depth (feet) 80
- (3) static water level (feet) 45 ^{below} _{above} top of ground.
- (4) casing PVC (material), (depth)
(size) if telescope see back.
- (5) screen 5 (length), 75 (depth to top)
2" (size), PVC (material)
- (6) pump 1/2 (HP), 6 (yield gpm)
elect (type power)
- (7) electric log (yes or no)

(organization running log)

(8) how well bottom plugged sand
SHARK

DRILLERS REMARKS: good well


Miss. Board of Water Comm.

MAR 6 - 1979

RECEIVED

If well telescopes please sketch and show depths.

GROUND LEVEL

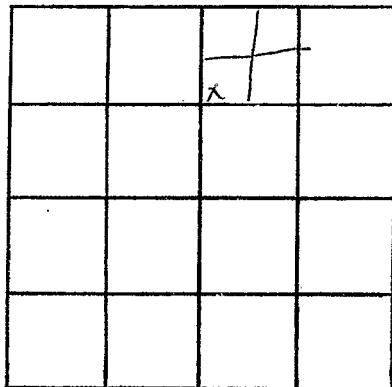

SECTION 11

Please indicate well location X.

ADDITIONAL INFORMATION

If more than one screen, show locations of each on sketch.