

MARION
 J 2046
 1-26-79

MISSISSIPPI
 BOARD OF WATER COMMISSIONERS
 416 North State Street
 Jackson, Mississippi 39201

WATER WELL DRILLERS LOG

TOM GRIFFITH

1979 LUMBERING & WELL SERVICE, INC.

320 MAYOR BLVD.
 COLUMBIA, MS 39429

Marion county well located

Jan. 26
 date well completed

LANDOWNER:

Mr. Milton Rankin
 Rt. 2 - Foxworth Min.
 (mailing address)

description of formations encountered

from to

Sand	0	39
Gravel	39	58
Gravel	58	77
Sand	77	102
Clay	102	198
Sand	198	230

WELL LOCATION:

sec. 3 T 3 N R 12 E
 S W
 10 miles W of Columbia
 (distance) (direction) (nearest town)

WELL PURPOSE:

Home
 (home, irrigation, municipal, industrial)

WELL COMPLETION DATA:

- diameter (inches) 2"
- total depth (feet) 230 ft.
- static water level (feet) 120 ft. below top of ground.
- casing plastic, 100 ft. (material) (depth)
 2" (size) If telescope see back.
- screen 20 ft., 100 ft. (length) (depth to top)
 2" (size) plastic (material)
- pump 2 HP, 7 (HP) (yield gpm)
 Electric (type power)
- electric log No (yes or no)

(organization running log)

(8) how well bottom plugged Back Wash Valve

DRILLERS REMARKS:


Miss. Board of Water Comm.

FEB 23 1979

RECEIVED

If well telescopes please sketch and show depths.

GROUND LEVEL

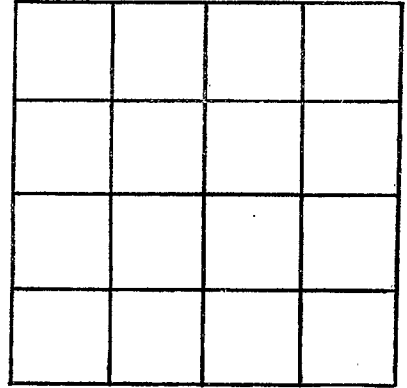

SECTION _____

Please indicate well location X:

ADDITIONAL INFORMATION

If more than one screen,
show locations of each on sketch.