

MARION

J 2047

2-01-79

MISSISSIPPI BOARD OF WATER COMMISSIONERS
416 North State Street
Jackson, Mississippi 39201

WATER WELL DRILLERS LOG

2/1 19 79 Hollingsen Well Service MARION
date well completed firm name county well located

LANDOWNER: <u>Mack Rowley</u> <u>RT1</u>	description of formations encountered	from	to
<u>Kokomo, MS</u> (mailing address)	<u>sand, chert</u> <u>sand, gravel</u>	<u>0</u> <u>120</u>	<u>120</u> <u>150</u>
WELL LOCATION: sec. <u>16</u> T. <u>3</u> (N) R. <u>12</u> (E) <u>3</u> miles <u>N</u> of <u>Kokomo</u> (distance) (direction) (nearest town)			
WELL PURPOSE: <u>Home</u> (home, irrigation, municipal, industrial)			
WELL COMPLETION DATA:			
(1) diameter (inches) <u>2"</u>			
(2) total depth (feet) <u>150</u>			
(3) static water level (feet) <u>60</u> ^{below} above top of ground.			
(4) casing <u>PVC</u> <u>145</u> (material) (depth)			
<u> </u> if telescope see back. (size)			
(5) screen <u>5</u> <u>145</u> (length) (depth to top)			
<u>2"</u> <u>PVC</u> (size) (material)			
(6) pump <u>1</u> <u>7</u> (HP) (yield gpm)			
<u>elect</u> (type power)			
(7) electric log <u> </u> (yes or no)			
<u> </u> (organization running log)			
(8) how well bottom plugged <u>sand</u> <u>SHARK</u>			
DRILLERS REMARKS: <u>Good well</u>			


Misc. Board of Water Comm.

MAR 6 - 1979

RECEIVED

If well telescopes please sketch and show depths.

GROUND LEVEL

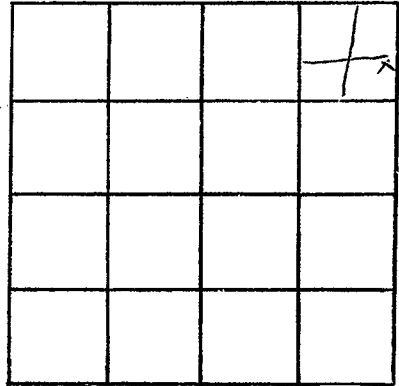

SECTION 16

Please indicate well location X.

ADDITIONAL INFORMATION

If more than one screen, show locations of each on sketch.