

MARION
J 2048
2-12-79

**MISSISSIPPI
BOARD OF WATER COMMISSIONERS**
416 North State Street
Jackson, Mississippi 39201

WATER WELL DRILLERS LOG

2/12/79 1979 Hollinsie Well Service Marion
date well completed firm name county well located

LANDOWNER: Sara Robutson
RT1
Foxworth, Ms.
(mailing address)

description of formations encountered	from	to
CLAY, GRAVEL	0	50
SAND	50	100
SAND & GRAVEL	100	80

WELL LOCATION:
sec. 9 T. 30 N. R. 20 ¹² W.
9 miles W of Foxworth
(distance) (direction) (nearest town)

WELL PURPOSE: Home
(home, irrigation, municipal, industrial)

WELL COMPLETION DATA:

(1) diameter (inches) 2"

(2) total depth (feet) 180

(3) static water level (feet) 60 ^{below} above top of ground.

(4) casing PVC (material) (depth) (size) If telescope see back.

(5) screen 5 (length) (depth to top) 2" (size) PVC (material)

(6) pump 1 (HP) 8 (yield gpm) elect (type power)

(7) electric log (yes or no)

(organization running log)

(8) how well bottom plugged sand SHARK


DRILLERS REMARKS: Very good

MISS. BOARD OF WATER COMM.

APR 6 - 1979

If well telescopes please sketch and show depths.

GROUND LEVEL

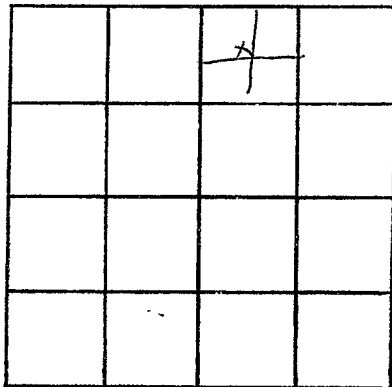

SECTION 9

Please indicate well location X.

ADDITIONAL INFORMATION

If more than one screen,
show locations of each on sketch.