

MARION
J 2049
4-7-79

MISSISSIPPI
BOARD OF WATER COMMISSIONERS
416 North State Street
Jackson, Mississippi 39201

WATER WELL DRILLERS LOG

4-7 1979 *Fitzgerald Well Serv* *Marion*
date well completed firm name county well located

LANDOWNER:
Bernard Casimano
R.R. Kolomo
(mailing address)

description of formations encountered	from to	
	feet	feet
<i>Reel Clay</i>	0	20
<i>Reel Sand</i>	20	130
<i>Coarse sand & gravel</i>	130	140

WELL LOCATION:
sec. 27 T. 30 N. R. 12 E. S. W
1 miles E of Kolomo
(distance) (direction) (nearest town)

WELL PURPOSE:
(home, irrigation, municipal, industrial) Home


- WELL COMPLETION DATA:
- (1) diameter (inches) 4
 - (2) total depth (feet) 140
 - (3) static water level (feet) 75 below above top of ground.
 - (4) casing PVC 132
(material) (depth)
4 if telescope see back.
(size)
 - (5) screen 8 132
(length) (depth to top)
4 PVC
(size) (material)
 - (6) pump 1/2 10
(HP) (yield gpm)
Electric
(type power)
 - (7) electric log yes
(yes or no)
 - (8) how well bottom plugged Sand filled
(organization running log)

DRILLERS REMARKS:

Miss. Board of Water Comm.
MAY 30 1979
RECEIVED

If well telescopes please sketch and show depths.

GROUND LEVEL

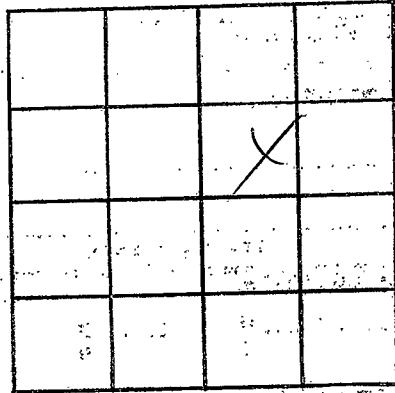

SECTION 37

Please indicate well location X

ADDITIONAL INFORMATION

If more than one screen, show locations of each on sketch.