

Marion
J 2051

MISSISSIPPI
BOARD OF WATER COMMISSIONERS
416 North State Street
Jackson, Mississippi 39201

7-2-79
July 2 1979
date well completed

WATER WELL DRILLERS LOG

TOM GRIFFITH
PLUMBING & WELL SERVICE, INC.

Marion
county well located

LANDOWNER:

Mr. Milton Rankin

Rt. 4 Box 535 - Columbia
(mailing address) Miss.

WELL LOCATION:

sec. 11 T. 30N R. 12E
7 miles W of Columbia
(distance) (direction) (nearest town)

WELL PURPOSE:

Home
(home, irrigation, municipal, industrial)

WELL COMPLETION DATA:

- (1) diameter (inches) 2"
- (2) total depth (feet) 220 ft.
- (3) static water level (feet) 100 ft. below top of ground.
- (4) casing plastic 200 ft.
(material) (depth)
2" (size) if telescope see back.
- (5) screen 20 ft. 200 ft.
(length) (depth to top)
2" plastic
(size) (material)
- (6) pump 1 HP 10 gpm
(HP) (yield gpm)
Electric
(type power)
- (7) electric log No.
(yes or no)

(organization running log)

(8) how well bottom plugged
Back Wash Valve

description of formations encountered

from to

description of formations encountered	from	to
gravel	0	2
clay	2	8
hard	8	14
gravel	14	29
clay	29	52
clay	52	129
gravel	129	180
clay	180	220


Rec'd 9/21/79

DNR-LW

DRILLERS REMARKS:

If well telescopes please sketch and show depths.

GROUND LEVEL

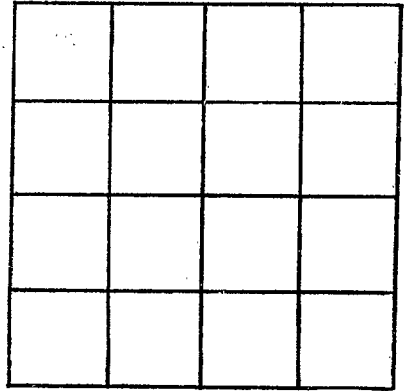

SECTION _____

Please indicate well location X.

ADDITIONAL INFORMATION

If more than one screen,
show locations of each on sketch.