

Mason
J
2054
8-30-79
8/30 1979
 date well completed

MISSISSIPPI
 BOARD OF WATER COMMISSIONERS
 416 North State Street
 Jackson, Mississippi 39201

WATER WELL DRILLERS LOG
 TOM GRIFFITH

PLUMBING & WELL SERVICE, INC. Mason
 firm name county well located

LANDOWNER:
Mr. Herman Martin
Rt. 1 Box 174
Bohoms, Miss.
 (mailing address)

description of formations encountered	from	to
<u>Top soil</u>	<u>0</u>	<u>1</u>
<u>Clay</u>	<u>1</u>	<u>60</u>
<u>Sand</u>	<u>60</u>	<u>71</u>
<u>Chalk</u>	<u>71</u>	<u>104</u>
<u>Gravel</u>	<u>104</u>	<u>225</u>

WELL LOCATION:
20 T 3 N R 12 E
S W
2 miles W of Bohoms
 (distance) (direction) (nearest town)

WELL PURPOSE: Home
 (home, irrigation, municipal, industrial)

- WELL COMPLETION DATA:
- (1) diameter (inches) 2"
 - (2) total depth (feet) 225 ft.
 - (3) static water level (feet) 120 ft. below top of ground.
 - (4) casing plastic 205 ft.
 (material) (depth)
2" If telescope see back.
 (size)
 - (5) screen 20 205 ft.
 (length) (depth to top)
2" plastic
 (size) (material)
 - (6) pump 1 HP 10
 (HP) (yield gpm)
Electric
 (type power)
 - (7) electric log No
 (yes or no)

(organization running log)

(8) how well bottom plugged Back Wash Valve

DRILLERS REMARKS:


DEPT. OF NATURAL RESOURCES
 BUREAU OF LAND & WATER RESOURCES

NOV 21 1979

RECEIVED

If well telescopes please sketch and show depths.

GROUND LEVEL

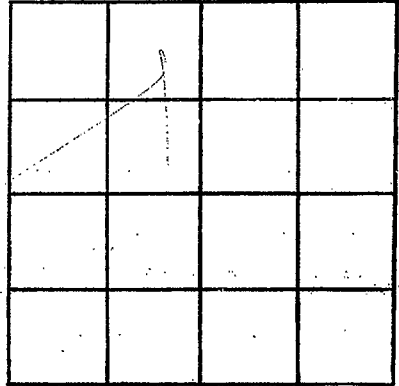

SECTION _____

Please indicate well location X.

ADDITIONAL INFORMATION

If more than one screen, show locations of each on sketch.